

Oktibbeha

G37

Elog 52

MISSISSIPPI BOARD OF WATER COMMISSIONERS 416 North State Street Jackson, Mississippi 39201

CODED

WATER WELL DRILLERS LOG

Feb. 6, 1973 Herndon Well & Supply Co. Oktibbeha date well completed firm name county well located

Table with columns for well completion data and formation descriptions. Includes sections for Landowner (Bluefield Water Association), Well Location (Starkville, MS), Well Purpose (Rural Wat. Syst.), Well Completion Data (diameter 8 X 5, total depth 1438, static water level 86 below top of ground, casing Steel 502, screen 50, pump 30 HP), and Drillers Remarks.

CODED

10' - blank
20' - blank
40' - cap 1318
20' blank bottom 1438

50
1318

DEC 6 1973


If well telescopes please sketch and show depths.

GROUND LEVEL

← 1438' →

502'

50'

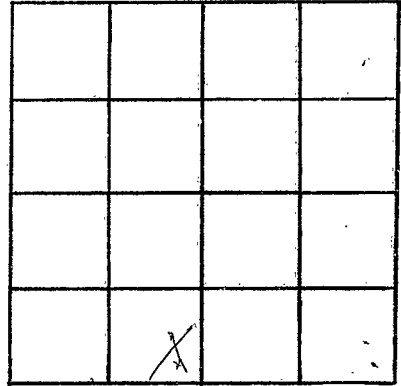

SECTION- 18

Please indicate well location X.

ADDITIONAL INFORMATION

If more than one screen, show locations of each on sketch.