

DRILLERS REMARKS:

(8) how well bottom plugged 10" BMV
 (organization running log) Bureau of Geology
 (7) electric log (yes or no) Yes
 (type power) electric
 (6) pump (HP) 200 (yield gpm) 1170
 (size) (material) 10" SS Ribbed
 (length) (depth to top) 81' 1360'
 (5) screen (size) 16" if telescope see back.
 (4) casing Steel (material) (depth) 1363'
 top of ground: 195' below
 (3) static water level (feet) 195' below
 (2) total depth (feet) 1441'
 (1) diameter (inches) 16" x 10"

WELL COMPLETION DATA:

WELL PURPOSE: Municipal (home, irrigation, municipal, industrial)
 (distance) (direction) of (nearest town) miles
 Inside city limits
 sec. 10 T 18 N R 14 E
 WELL LOCATION:
 (mailing address)

LANDOWNER: City of Starkville
 Starkville, MS 39759

date well completed 1983 November 22
 firm name Herndon Well & Supply, Inc. Oktibeha county well located

OKTIBEHA
 G39
 Log # 79 12/83

MISSISSIPPI
 BOARD OF WATER COMMISSIONERS
 416 North State Street
 Jackson, Mississippi 39201
 (601) 1339

WATER WELL DRILLERS LOG

CODED

description of formations encountered	from	to
Black Clay	0	18
Limestone	18	735
Rock	735	735
Limestone	735	810
Rock	810	810
Limestone	810	850
Sand	850	870
Limestone	870	880
Rock	880	880
Sand & Limestone Streaks	880	1025
Rock	1025	1025
Sand & Limestone Streaks	1025	1035
Blue Clay	1035	1110
Sand & Limestone Streaks	1110	1180
Blue Clay w/Streaked Sand	1180	1275
Pink Gumbo	1275	1290
Sand & Clay Streaks	1290	1320
Pink Gumbo	1320	1345
Sand	1345	1440
Pink Gumbo & Sand Streak	1440	1500

RECEIVED

DEC 21 1983


RECEIVED

DEPT. OF NATURAL RESOURCES
 BUREAU OF LAND & WATER RESOURCES

①

If well telescopes please sketch and show depths.

GROUND LEVEL

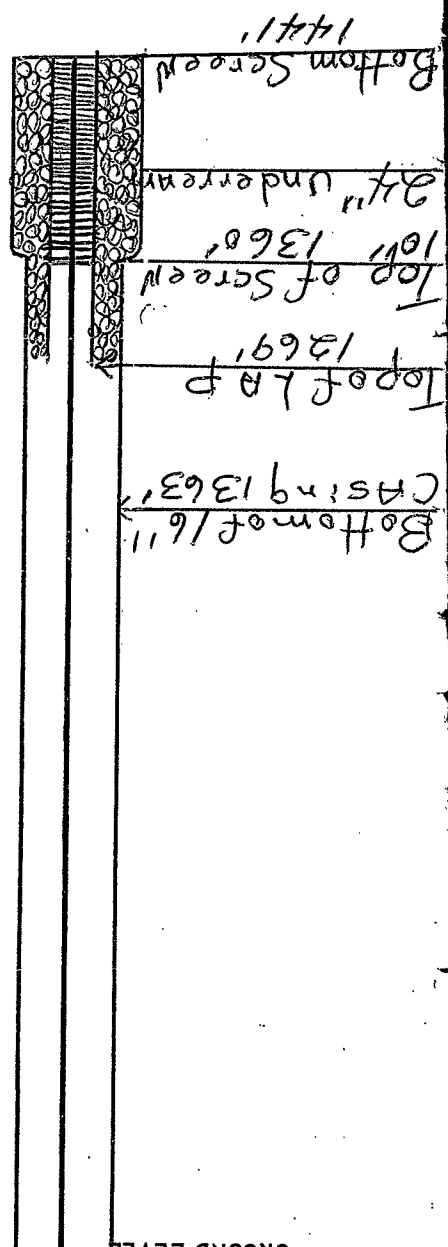

If more than one screen, show locations of each on sketch.

ADDITIONAL INFORMATION

Please indicate well location X
SECTION 10

X			

ALBERTA