

MISSISSIPPI DEPARTMENT OF ENVIRONMENTAL QUALITY
Office of Land and Water Resources

P. O. Box 10631
Jackson, MS 39289-0631
WATER WELL DRILLERS LOG

COUNTY WELL LOCATED OKTIBBEHA	
WELL NUMBER 2	CODED
G-46	
DATE WELL COMPLETED 12-15-01	

PERMIT NUMBER
NAME OF DRILLING FIRM PARKS + PARKS WELL SERVICE
HOUSTON, MS. 38851

NAME & MAILING ADDRESS OF LANDOWNER STARKVILLE COUNTRY CLUB S. MONTGOMERY ST STARKVILLE MS. 39760			
Latitude:			
Longitude:			
WELL LOCATION.	SEC	TOWNSHIP	RANGE
	23	18 ^(N) _(S)	14 ^(E) _(W)
DISTANCE	DIRECTION	NEAREST TOWN	
4 Miles	SOUTH	of STARKVILLE	
OTHER LANDMARK			
WELL PURPOSE: Home, Irrigation, Municipal, Industrial, Fish Pond, etc.			

PUMP DATA			
PUMP TYPE (Circle One):			
<input checked="" type="radio"/> Submersible,	<input type="radio"/> Turbine,	<input type="radio"/> Jet	<input type="radio"/> Flowing Well,
Other (Describe)			
POWER TYPE (Circle One):			
<input checked="" type="radio"/> Electric,	<input type="radio"/> Tractor,	<input type="radio"/> Diesel,	<input type="radio"/> Gasoline, <input type="radio"/> Butane,
Other (Describe) _____ H/P 7 1/2			

DESCRIPTION OF FORMATIONS ENCOUNTERED	FROM	TO
TOP Soil	0	0
CLAY	8	460
SAND-CLAY	460	480
CLAY	480	790
SAND - ROCK - CLAY	790	810
SAND	810	830
SAND-CLAY	830	852
SAND	852	885
SAND-CLAY	885	1008
SAND-SHELL	1008	1040
CLAY	1040	1135
SAND	1135	1260
GRAVEL	1260	1360
CLAY	1360	1365

WELL DATA		
Well Depth 1350	Casing Diameter (In.) 4 X 2	Casing Length (Ft.) 1270
Type of Casing STEEL	Hole Depth 1365	Depth to Static Water Level
TYPE OF COMPLETION: (Circle One or More):		
<input checked="" type="radio"/> Gravel Packed,	<input type="radio"/> Underreamed,	<input type="radio"/> Telescoped,
<input type="radio"/> Natural Development,	<input type="radio"/> Open Hole,	<input type="radio"/> Other
(Describe)		

WELL GROUTED TO A DEPTH OF _____ FEET
Type Grout (circle one): Cement, Bentonite, or Mix

SCREEN DATA		
Diameter - Inches 2	Length - Feet 80	Slot Size - Inches .012
Screen Type SS	Depth to Bottom - Feet 1350	


RECEIVED	
FEB 15 2002	
BY: OLWR	
Top of Lap Pipe or Reduction in Casing	FEET
	IF TELESCOPED OR MORE THAN ONE SCREEN: USE BACK PAGE

I certify that the well was drilled, constructed and completed in accordance with all applicable Requirements of the Mississippi Department of Environmental Quality and/or the Mississippi Department of Health regulations and state laws.

Raymond L. ...
Signature of Licensed Driller and License No.

1/30/02
Date

If well telescopes please sketch and show depths.

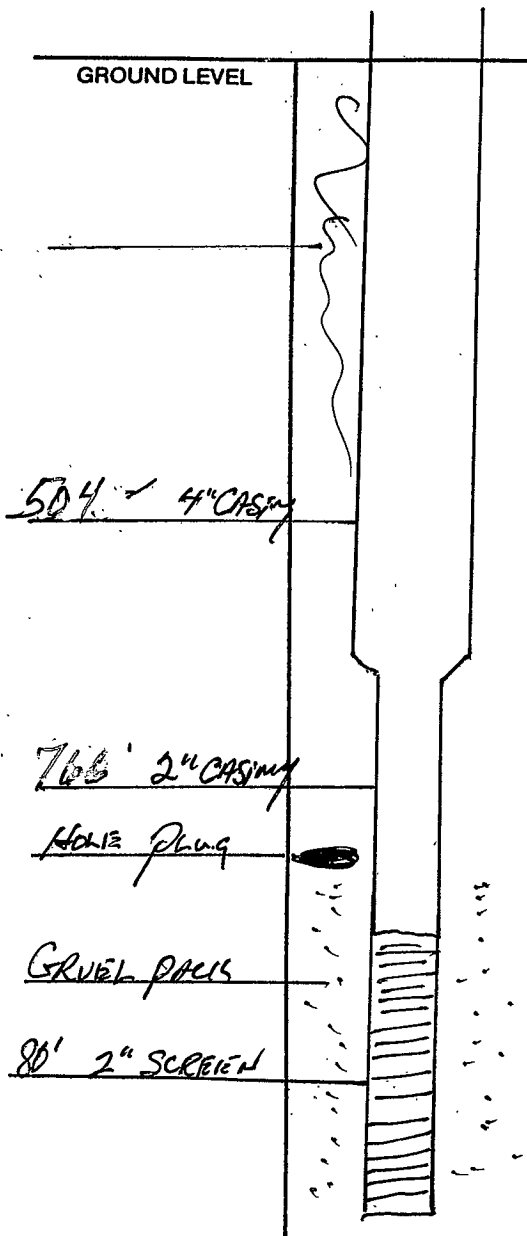

SECTION _____

Please indicate well location X.

Pump Capacity (GPM)	No. of Stages	Setting Depth
55		315 FT.

PUMP TEST

Well yielded _____ GPM with
 a drawdown of _____ ft.
 after _____ hours of pumping

LOG DATA

TYPE OF LOG RUN (Circle One): No Log Run
 Electric, Gamma Ray, Density, Sonic, Neutron,
 Other (Describe) _____

Name of Organization Running Log _____

GEOLOGIC DATA (Office Use Only)

Surface Elev.	Geologic Unit	Unit Thickness	Depth to Top
Subs. SWL	Date	Analysis	Aquifer Test

Driller's Remarks

If more than one screen,
 show location of each on sketch.