State Well Report					
County: OKTIBBAHA	For Office Use Only:				
* . *		Part 1 – Driller's Log Mississippi Department of Environmental Quality			
Permit #:		and Water Resources	Aquifer:		
Driller: PANKS & PANKS		Box 2307	Well #: <u>6109</u>		
Driller: 1719CS		n, MS 39225	L. S. Elevation:		
Date drilling completed: 16 26/12		961- 5210 1- 5228 (fax)			
	(001)00	1.0220 (102)	E-log #:		
State Law requires that this repor Department at the above address				ie	
Information on Well O			rehole Location		
(Landowner if borehole is not fo	r a water well)	02.02.20		/10	
Owner Name OKTOC WATE	an Accal	Latitude: 33 ° 22 ' 33	" Longitude: 60° 71'	77	
Mailing Address: P.O. Box 30	_	Method of Lat/Long (circle on	e): Conventional Survey,		
Stankyille	,	USGS quad, Hand-held	GPS, Survey-grade GPS	4 E	
SIMP TOWE	<i>- 1113</i>	5E 4 SE 4 Sec 35	Twn /8N Rng /4	W	
City State	•	Distance Direction	Nearest Town		
City State Zip Code Distance Direction Nearest Town. Telephone No. (61) 418-3438 Telephone No. (62) 418-3438					
	Well / Bore	hole Data			
Date drilling started: 9/1 Date drilling completed: 10/16 Hole depth: 1490 Hole diameter: 10×6					
Location of the source of any surface water used for drilling: Method of dosing and volume of Chlorine used in drilling and development:					
Logs run (circle all applicable): No log run Electric Gamma Ray Density Sonic Neutron Other:					
Purpose of borehole (check one): Water Well Geotechnical/Geological Investigation Ground Source Heat Pump					
Seismic Survey Other (describe)					
If drilling is not related to water well construction, skip the remainder of this block					
Purpose of Well (check one): Home Inc	lustrial Public Supply	Irrigation Fish Culture	_ Other: _ •		
If a flowing well, method of flow regulation: Valve Other (describe)					
Static Water Level: 2/9 feet above or below (circle one) land surface Date measured: 1//3//2					
Method of Measurement (circle one) steel tape electric tape air line other:					
Well depth: 140 Well grouted to a depth of 370eet Type of grout (circle one) Neat Cement Bentonite Mix					
Casing length: 1370 feet Casing	diameter: 10	inches Type of casing:	Sveel	_	
Screen length: Con feet Screen	diameter:	inches TourseCourse	In done	-/	

1375

Gravel packed Underreamed Telescoped Open hole

1310 feet. If telescoped or more than one screen, describe on next page

feet to 143.

Setting depth: From _

Other (describe):

Type of completion (circle all applicable)

Top of lap pipe or reduction in casing:


Form: OLWR-SWR-1A (04/08)

Natural Development

	The	sketch	below	only	required	for	water wells
--	-----	--------	-------	------	----------	-----	-------------

Description of formations encountered must be provided for all wells and boreholes, unless specifically exempted by regulations

If well telescopes, show Ground Level	depins on sketch.	Description of Formations Encountered	From (depth)	To (depth)
Ground 2010			Ground Level	
[3]		CIAN & SAND	Ó	50
31 18		CLAY & LIMPSTONE	50	1180
S = S		sambu clay	1180	1280
11 18	1370 COMENT	DINK GLAM HARD	1780	1340
}		SAND & GARVE	1340	1460
	1370-10 CASING			
3) [5	1370-10 CASING			
)				<u> </u>
}				
				ļ
\$1 1 \$				<u> </u>
31 K				
31 13	1-1-1			
<u> </u>	1310 Tep or lap			ļ
\\\\\\\\\\\\\\\\\\\\\\\\\\\\\\\\\\\\\\				-
	1 11 00			
	60-6 LAPTIFE			
八百八十二十二十二十二十二十二十二十二十二十二十二十二十二十二十二十二十二十二十	1310' Tép of lap 60'-6' Lapfife 60'-6' Screen			
N. Carl	60-6 Scheen			
			 	
	grave tack		 	
			 	
TOTAL DOPA 1490	BACK PRESSURE Valve			<u> </u>
of more than one scre	en, show location of each on sketch	•		
AN ANNA MANA DATA DATA				

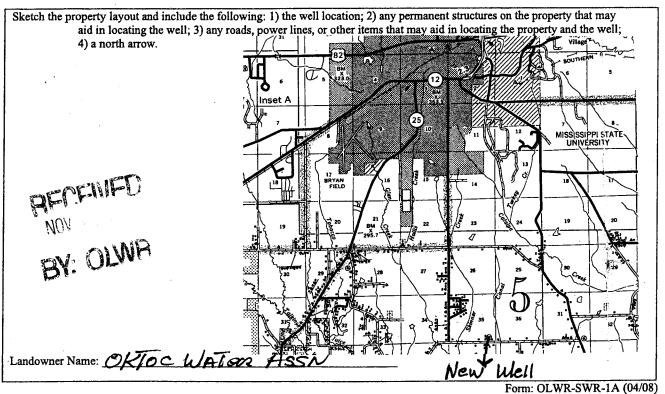

I certify that the well/borehole was drilled, constructed, and completed in accordance with all applicable requirements of the Mississippi Department of Environmental Quality and the Mississippi Department of Health regulations, if applicable, and state

RAGOURW HAKS 0-414 11/15/12 Maybuurfaure

Print Name of Responsible Licensee and License No. Date Signature of Licensee

STATE WELL REPORT

Part 2

Pump Installer's Completion Report Mississippi Department of Environmental Quality Permit #: Office of Land and Water Resources P.O. Box 10631 Jackson, MS 39289-0631 Date completed: 10/26 (601)961-5210

County: OKTI 66AAA

For Office Use Only:				
Aquifer:				
Well #:G\09				
Elevation:	-			

(601)354-6938 (fax) Copy information from block on Part 1 This part of the report must be completed by a licensed water well contractor or a licensed pump installer. A copy of Part 1 of the report must be attached and both parts filed with the Department at the above address within 30 days of well completion. Well Location Well Owner Information Owner Name: OKTOC WATER HISSN Latitude: Longitude: ____ Mailing Address: P.D. Kox 304 Method of Lat/Long (check one): Conventional Survey____, USGS quad , Hand-held GPS ___, Survey-grade GPS ___ SE 1/2 SEC 35 T 18NR 14W City Zip Code State Direction Nearest Town Distance 4 Miles South of STARKVILLE Telephone No. (662) 4/8-3438 Power Type Pump Type Circle one Circle one Natural Gas Gasoline Engine Jet Submersible Diesel Engine Air Lift Tractor PTO Electric Motor Hand Turbine Bucket Piston Other (specify): Windmill Centrifugal Rotary Flowing Well Horse Power Rating of Motor: ______ Other (specify): Date Pump Installed: 11 2 12 Setting Depth: 336 feet Rated Pump Capacity: ________ Gallons Per Minute Number of Stages: _____ Method of Measuring Water Level Pump Test Data Circle one Date Well Tested: Electric Measuring Line Steel Tape Air Line Static Water Level (A): ________ Feet Below Land Surface Other (specify): Pumping Water Level (B): 286 Feet Below Land Surface Drawdown [(B) – (A)]: 67 Feet Below Land Surface For flowing well, measured shut in head: _____feet Well yielded _____ GPM with a drawdown of Test Pumping Rate: _____ Gallons Per Minute feet after hours of pumping Duration of Pump Test (minimum 4 hours):

I HEREBY, CERTIFY that the above statements are true to the best of my knowledge.

THY DURIN JARKS 8464 rint Name of Pump Installer and License No. (if applicable)

Signature of Jump Installer