

O.K.T.  
H 17  
9-10-64

WATER WELL DRILLERS LOG

O.K.T.

Date: Sept 10, 1964, Driller: Robert E. Raloff County: Itaska  
(Name)

(1) Owner of Land: Jamba Arab water  
(Name)  
Starville Missis  
(Address)

(2) Location: 1/4, 1/4, Sec.     T.     R.      
3 miles S.E. of Starville  
(distance) (direction) (Nearest Town)

(3) Topography: Hilly  
(Hilly) (Flat) (Level)

(4) Purpose of Well: Municipal  
(Domestic Irrigation) (Municipal, Industrial, Other)

Description & Color of Materials Sand, Clay, Red Clay, Shell, etc.	Thick- ness Feet	Depth Feet
Rock + shale	1016	1058
land + shale	1058	1078
shale, sand, Rock	1078	1107
sand	1107	1137
Rock	1137	1139
Rock	1139	1144
shale, streaks sand	1144	1170
shale + lime shells	1170	1175
Rock	1175	1185
shale + lime shell	1185	1201
shale + lime shell	1201	1210
sand	1210	1216
Hard lime shale streak	1216	1232
shale, sand, + Rock	1232	1294
shale + sand	1294	1324
shale + sand	1324	1355
sand	1355	1387
sand	1387	1407
shale	1407	1417
shale	1417	1436

Information upon completion of well:

(1) Diameter 8x4 inches.

(2) Total Depth 1436 feet.

(3) Water Level 150 feet below top of ground.


(4) Cased to 1436, Size 8x4

(5) Screen: Size 4", Length 40 ft.

(6) Were any formations sealed against pollution?  
 yes,  no.

If YES depth of formation Cemented  
Why    

Drillers Remarks:    

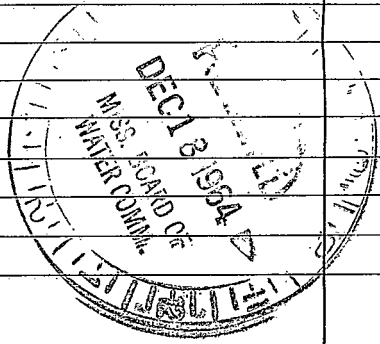

(Use Back Side)

Well No.

17

17

