

Oktibbeha  
 H 19  
 8-70

MISSISSIPPI  
 BOARD OF WATER COMMISSIONERS  
 416 North State Street  
 Jackson, Mississippi 39201

**CODED**

WATER WELL DRILLERS LOG

Aug 19 70 Norman Colaba Oktibbeha  
 date well completed firm name county well located

LANDOWNER: Billy Petty  
RFD #4  
Starbuck, Miss  
 (mailing address)

description of formations encountered	from	to
Top Soil	0	10
Thin Sand	10	481
Sand Rock	481	527

WELL LOCATION:  
 sec 2 T 18 (N) R 15 (E)  
6 miles W of Starbuck  
 (distance) (direction) (nearest town)

WELL PURPOSE:  
 (home, irrigation, municipal, industrial)

WELL COMPLETION DATA:

- (1) diameter (inches) 4
- (2) total depth (feet) 527'
- (3) static water level (feet) 80 below above top of ground.
- (4) casing 21' 4"  
 (material) (depth)  
 (size) if telescope see back.
- (5) screen 0   
 (length) (depth to top)  
 (size) (material)
- (6) pump 1 hp 50 gpm  
 (HP) (yield gpm)  
Electric  
 (type power)
- (7) electric log   
 (yes or no)  
  
 (organization running log)
- (8) how well bottom plugged

**CODED**


SEP 22 1970

MISS. BD. OF  
 WATER COMM.

DRILLERS REMARKS:

If well telescopes please sketch and show depths.

GROUND LEVEL

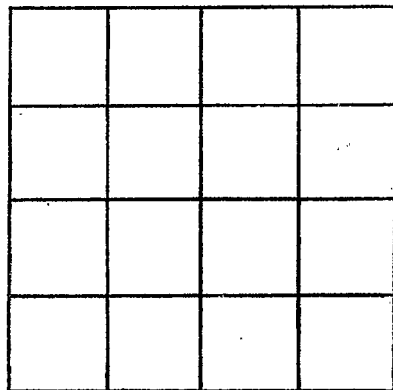

SECTION \_\_\_\_\_

Please indicate well location X.

ADDITIONAL INFORMATION

If more than one screen,  
show locations of each on sketch.