

Okibbeha

H 21

6-20-73

MISSISSIPPI  
 BOARD OF WATER COMMISSIONERS  
 416 North State Street  
 Jackson, Mississippi 39201

CODE

WATER WELL DRILLERS LOG

June 20  
date well completed

19 73 HERMAN ECHOLS  
firm name

OKIBBEHA  
county well located

LANDOWNER:	description of formations encountered	from	to
Joe Mearcy	Dark Clay	0	9
Ortens, Miss (mailing address)	Chalk Sand & Peb	8	580 580 700
<b>WELL LOCATION:</b>			
sec. 26 T. 18 (N) S R. 15 (E) W			
6 miles West of Ortens (distance) (direction) (nearest town)			
<b>WELL PURPOSE:</b> (home, irrigation, municipal, industrial)			
<b>WELL COMPLETION DATA:</b>			
(1) diameter (inches) 5"			
(2) total depth (feet) 700'			
(3) static water level (feet) 100 below above top of ground.			
(4) casing Steel 21' (material) (depth)			
5" if telescope see back. (size)			
(5) screen 0 (length) (depth to top)			
(size) (material)			
(6) pump 3/4 10 (HP) (yield gpm)			
E. Unit. (type power)			
(7) electric log none (yes or no)			
(organization running log)			
(8) how well bottom plugged			
<b>DRILLERS REMARKS:</b>			


CODED

JUN 30 1973

RD. 05  
WATER POWER

If well telescopes please sketch and show depths.

GROUND LEVEL

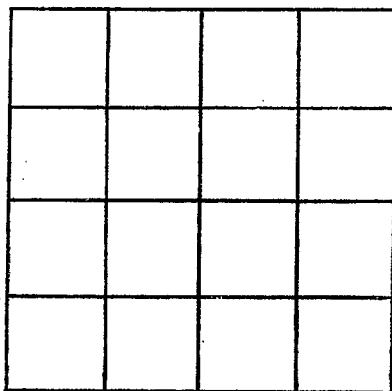


SECTION \_\_\_\_\_

Please indicate well location X.

ADDITIONAL INFORMATION

If more than one screen, show locations of each on sketch.