

MISSISSIPPI DEPARTMENT OF ENVIRONMENTAL QUALITY

Office of Land and Water Resources

P. O. Box 10631  
Jackson, MS 39289-0631

WATER WELL DRILLERS LOG

COUNTY WELL LOCATED  
Oshtobeha

WELL NUMBER 2 CODED

H-29

DATE WELL COMPLETED  
11-15-01

PERMIT NUMBER  
GW 15834

NAME OF DRILLING FIRM  
PARKS + PARKS WELL SERVICE

HOUSTON, MS 38657

NAME & MAILING ADDRESS OF LANDOWNER  
TURKEY CREEK WATER ASSN.  
1528 Hullbrook Dr.  
STARKVILLE MS.

Latitude:  
Longitude:

WELL LOCATION. SEC 18 TOWNSHIP 18 S RANGE 15 W

DISTANCE 3 Miles DIRECTION SE of NEAREST TOWN STARKVILLE

OTHER LANDMARK

WELL PURPOSE: Home, Irrigation, Municipal, Industrial, Fish Pond, etc.  
WATER ASSOCIATION

PUMP DATA

PUMP TYPE (Circle One):  
Submersible, Turbine Jet Flowing Well,  
Other (Describe)

POWER TYPE (Circle One):  
Electric Tractor, Diesel, Gasoline, Butane,  
Other (Describe) 40 H/P

DESCRIPTION OF FORMATIONS ENCOUNTERED	FROM	TO
CLAY	0	120
CLAY LIMESTONE	120	638
CLAY, LIMESTONE, + SAND	638	670
SAND + ROCK	670	732
SAND	732	793
SAND + CLAY	793	854
SAND	854	885
SAND-CLAY	885	1008
SAND - SHELL	1008	1069
SHELL - CLAY	1069	1161
CLAY	1161	1223
SHELL	1223	1284
SAND CLAY	1284	1346
SAND	1346	1378
SAND - GRAVEL	1378	1401
SAND	1401	1420
CLAY	RECEIVE	1420

WELL DATA

Well Depth <u>1395</u>	Casing Diameter (In.) <u>12 3/4</u>	Casing Length (Ft.) <u>13 15</u>
Type of Casing <u>STEEL</u>	Hole Depth <u>1420</u>	Depth to Static Water Level <u>231.65'</u>

TYPE OF COMPLETION: (Circle One or More):  
Gravel Packed, Underreamed, Telescoped,  
Natural Development, Open Hole, Other  
(Describe)

WELL GROUTED TO A DEPTH OF 1315 FEET  
Type Grout (circle one) Cement, Bentonite, or Mix

SCREEN DATA

Diameter - Inches <u>6</u>	Length - Feet <u>75</u>	Slot Size - Inches <u>.020</u>
Screen Type <u>STAINLESS</u>	Depth to Bottom - Feet <u>1395'</u>	

FEB 10 2002

BY: OLWR

Top of Lap Pipe or Reduction in Casing  
1260 FEET

IF TELESCOPED OR MORE THAN ONE SCREEN: USE BACK PAGE


I certify that the well was drilled, constructed and completed in accordance with all applicable Requirements of the Mississippi Department of Environmental Quality and/or the Mississippi Department of Health regulations and state laws.

[Signature]  
Signature of Licensed Driller and License No.

2/9/02  
Date

Additional Information Required On Back

If well telescopes please sketch and show depths.

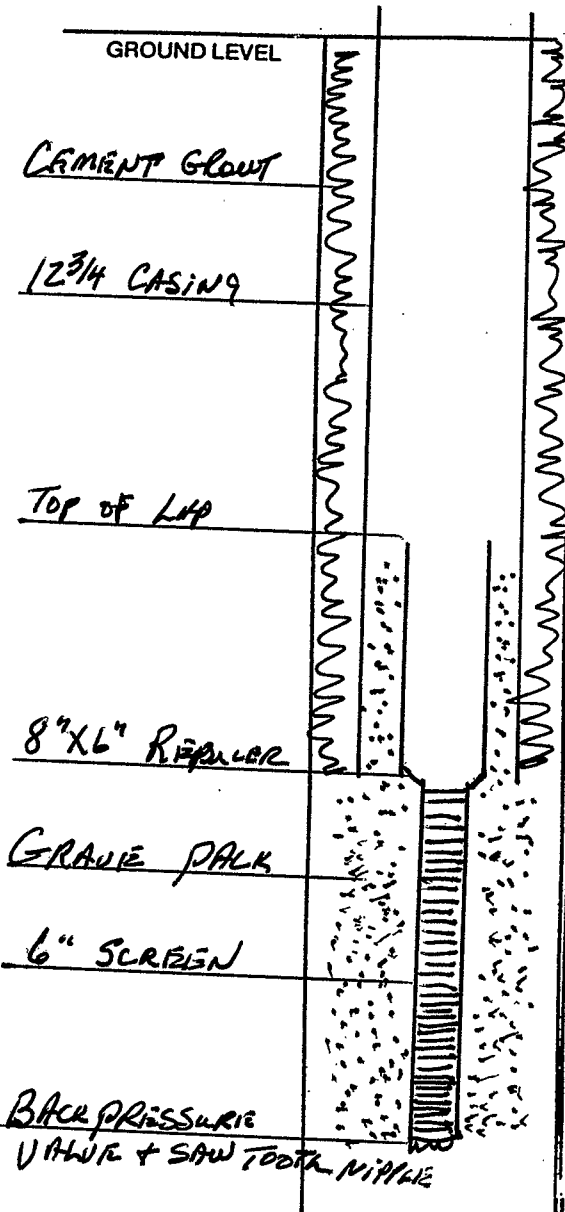


SECTION \_\_\_\_\_

Please indicate well location X.

Pump Capacity (GPM)	No. of Stages	Setting Depth
250	8	290 FT.
PUMP TEST		
Well yielded <u>250</u> GPM with		
a drawdown of <u>19.15</u> ft.		
after <u>8</u> hours of pumping		

LOG DATA

TYPE OF LOG RUN (Circle One):  Electric  Gamma Ray  Density  Sonic  Neutron  No Log Run, Other (Describe) \_\_\_\_\_

Name of Organization Running Log  
MSG S

GEOLOGIC DATA (Office Use Only)

Surface Elev.	Geologic Unit	Unit Thickness	Depth to Top
Subs. SWL	Date	Analysis	Aquifer Test

Driller's Remarks

\_\_\_\_\_

\_\_\_\_\_

\_\_\_\_\_

\_\_\_\_\_

BACK PRESSURE  
VALVE + SAW TOOTH NIPPLE

If more than one screen, show location of each on sketch.