

OKTIBBEHA

H 2003

5-3-77

MISSISSIPPI BOARD OF WATER COMMISSIONERS

416 North State Street Jackson, Mississippi 39201

WATER WELL DRILLERS LOG

May 3 date well completed

1977 HERMAN ECHOLS firm name

OKTIBBEHA county well located

LANDOWNER: ELMER RUFF

description of formations encountered

from

to

RFD #4

Sandy clay

0

10

Starbuck Merit

clay

10

340

(mailing address)

Sand

340

454

WELL LOCATION:

sec. 1 T 18 N R 15 E

5 miles

North W. direction

OKTIBBEHA nearest town

(distance) (direction) (nearest town)

WELL PURPOSE:

Home (home, irrigation, municipal, industrial)

WELL COMPLETION DATA:

- (1) diameter (inches) 4
- (2) total depth (feet) 454
- (3) static water level (feet) 100 below top of ground.
- (4) casing 20 1/2" plastic (material) (depth)
- (size) If telescope see back.
- (5) screen (length) (depth to top)
- (size) (material)
- (6) pump 1/2 (HP) 10 G.P.M. (yield gpm)
- (type power)
- (7) electric log (yes or no)
- (organization running log)
- (8) how well bottom plugged


DRILLERS REMARKS:

RECEIVED MAY 20 1977

MISS. BD. OF WATER COMMISSIONERS

If well telescopes please sketch and show depths.

GROUND LEVEL

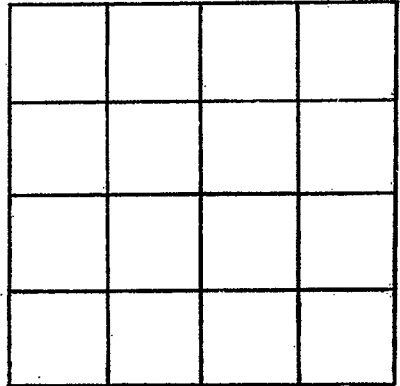

SECTION _____

Please indicate well location X.

ADDITIONAL INFORMATION

If more than one screen,
show locations of each on sketch.