

OKTIBBEHA

H 2005

6/21/77

MISSISSIPPI BOARD OF WATER COMMISSIONERS 416 North State Street Jackson, Mississippi 39201

WATER WELL DRILLERS LOG

June 19 77 HERMAN ECHOLS OKTIBBEHA date well completed firm name county well located

LANDOWNER: LUTHER MILLER

RFD # 4

STARKVILLE MS (mailing address)

WELL LOCATION:

sec 1 T 18 N R 15 E S W 5 miles NORTH of ARTESIA (distance) (direction) (nearest town)

WELL PURPOSE: HOME (home, irrigation, municipal, industrial)

WELL COMPLETION DATA:

- (1) diameter (inches)
(2) total depth (feet) 454
(3) static water level (feet) 100 below top of ground
(4) casing 20' 6" Plastic, 5/8" (material) (depth)
(5) screen (length) (depth to top)
(6) pump 1/2 (HP) 10 (yield gpm)
(7) electric log (yes or no)
(8) how well bottom plugged

description of formations encountered from to

Sandy clay 0 10
Clay 10 340
Sand 340 450

DRILLERS REMARKS:


RECEIVED

MAY - 1 1977

MISS. DE. OF WATER COMMISSIONERS

If well telescopes please
sketch and show depths.

GROUND LEVEL

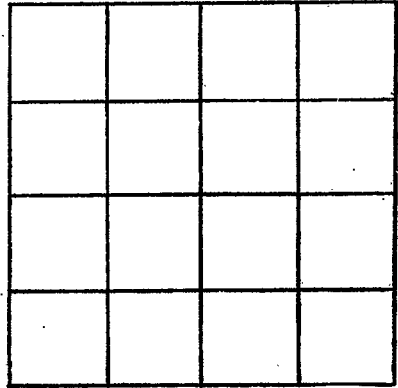

SECTION _____

Please indicate well location X.

ADDITIONAL INFORMATION

If more than one screen,
show locations of each on sketch.