

#55
LOG

OKTIBBEHA
M8
6-30-71

MISSISSIPPI
BOARD OF WATER COMMISSIONERS
416 North State Street
Jackson, Mississippi 39201

CODED

WATER WELL DRILLERS LOG

6-30 1971 Shanda Roman Well Oktibbeha
date well completed firm name Supply county well located

LANDOWNER: Pleasant Grove -
Chapel Hill Waters Assoc.
Oktibbeha County, Miss
(mailing address)

description of formations encountered	from	to
Red Clay	0	8
Lime Rock	8	700
lime sand	700	760
lime Rock	760	830
sand	830	850
lime Rock	850	930
sand	930	930
Rock	930	932
lime Rock	932	1050
Rock	1050	1051
lime Rock	1051	1115
Pink Gumbo	1115	1180
Gumbo	1180	1230
sand	1230	1290
Gumbo	1290	1308
Gravel	1308	1341

WELL LOCATION:
sec. 11 T. 17 N R. 15 E
miles 8 W of Actasia
(distance) (direction) (nearest town)

WELL PURPOSE: drinking
(home, irrigation, municipal, industrial)

WELL COMPLETION DATA:

(1) diameter (inches) 8 x 4

(2) total depth (feet) 1341

(3) static water level (feet) 170 below above top of ground.

(4) casing Steel 502'
(material) (depth)
8" if telescope see back.
(size)

(5) screen 61'4" 5236'
(length) (depth to top)
4" Stainless Steel
(size) (material)

(6) pump 20 156
(HP) (yield gpm)
electric
(type power)

(7) electric log yes
(yes or no)
USGS
(organization running log)

(8) how well bottom plugged B/w
Valve - Bronze

CODED

AUG 4 - 1971

MISS. BD. OF
WATER COMMISSIONERS

DRILLERS REMARKS:

⊕

If well telescopes please sketch and show depths.

GROUND LEVEL

502'
of 8-inch
casing


Cement bond

Lead
seal

Top of
LAP 17 1/2'
478 1/2'

61' 4" (15)
4" SS
screen

759'
of 4-inch
casing

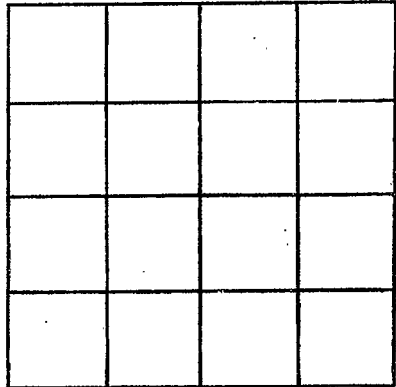

SECTION 11

Please indicate well location X.

ADDITIONAL INFORMATION

Bottom up.	1348
20' Screen	1321
40' Block	1281
41' 4" Screen	
759' Block	

If more than one screen, show locations of each on sketch.