

OKTIBBEHA

M11

3/78

EUG #67

MISSISSIPPI

BOARD OF WATER COMMISSIONERS

416 North State Street

Jackson, Mississippi 39201

CODED

WATER WELL DRILLERS LOG

March

19 78 Herndon Well & Supply, Inc.

Oktibbeha

date well completed

firm name

county well located

LANDOWNER: Chapel Hill - Pleasant Grove W. A.

Crawford, Ms.

(mailing address)

WELL LOCATION:

sec. 11 T. 17 N. R. 15 E of Crawford
5 miles (distance) NW (direction) (nearest town)

WELL PURPOSE: Community (home, irrigation, municipal, industrial)

WELL COMPLETION DATA:

- (1) diameter (inches) 8x5
(2) total depth (feet) 1380'
(3) static water level (feet) 180' below top of ground.
(4) casing steel, 1302', (material), (depth), 8" (size) if telescope see back.
(5) screen 50', 1302', (length), (depth to top), 5" (size), Stainless wrapped (material) on pipe
(6) pump 30 (HP), 207 (yield gpm), electric (type power)
(7) electric log yes (yes or no), U.S.G.S. (organization running log)
(8) how well bottom plugged 5" BWV

description of formations encountered

from

to

Table with 3 columns: description of formations encountered, from, to. Entries include Red Clay, Line Rock, Blue Rock, Sand (fine), Blue Rock, Sand, Gumbo, Sandy Streaks, Rock, Sandy Streaks, Gumbo, Sand, Blue Rock CODED, Sand (good), Gumbo, Sand (good), Clay.


RECEIVED stamp with date MAR - 9 1978

MISS. BD. OF WATER COMMISSIONERS stamp

DRILLERS REMARKS:

If well telescopes please sketch and show depths.

GROUND LEVEL

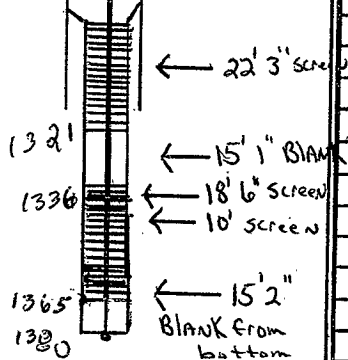

X			

SECTION 11

Please indicate well location X.

ADDITIONAL INFORMATION

If more than one screen, show locations of each on sketch.