

Oktibbeha
 M 200
 8-25-75

MISSISSIPPI
 BOARD OF WATER COMMISSIONERS
 416 North State Street
 Jackson, Mississippi 39201

WATER WELL DRILLERS LOG *Oktibbeha County*

8/25 1975 *Norman E. Egan* *Lawrence*
 date well completed firm name county well located

LANDOWNER: *Foreman James*
RFD #1 Box 287
Clumbert, Miss
 (mailing address)

description of formations encountered	from	to
<i>Clay</i>	<i>0</i>	<i>10</i>
<i>(Shale)</i>	<i>10</i>	<i>130</i>
<i>Sand</i>	<i>130</i>	<i>550</i>

WELL LOCATION: *136*
 sec. *2* T. *17* N. R. *15* E.
 S W
4 miles *W* of *Cayford*
 (distance) (direction) (nearest town)

WELL PURPOSE:
 (home, irrigation, municipal, industrial)

- WELL COMPLETION DATA:
- (1) diameter (inches) *5"*
 - (2) total depth (feet) *550*
 - (3) static water level (feet) *70* below top of ground.
 - (4) casing *21' 5"*
 (material) (depth)
 (size) if telescope see back.
 - (5) screen _____
 (length) (depth to top)
 (size) (material)
 - (6) pump *1/2* *10*
 (HP) (yield gpm)
Elect
 (type power)
 - (7) electric log (yes or no) _____
 (organization running log) _____
 - (8) how well bottom plugged _____


RECEIVED
 NOV 12 1975

MISS. RD. OF WATER COMM.

DRILLERS REMARKS:

If well telescopes please sketch and show depths.

GROUND LEVEL

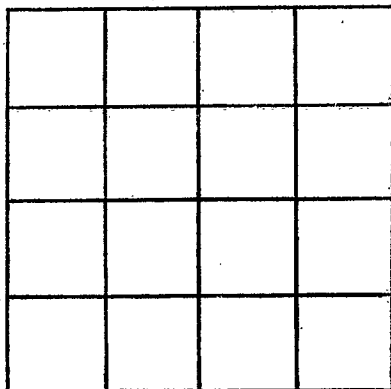

SECTION _____

Please indicate well location X.

ADDITIONAL INFORMATION

If more than one screen,
show locations of each on sketch.