


PANOLA
A

WATER WELL DRILLERS LOG

Date: 5-17, 1963, Driller: J B Cain County Panola
5-17-63 (Name)

(1) Owner of Land:	Description & Color of Materials Sand, Clay, Red Clay, Shell, etc.	Thick- ness Feet	Depth Feet
<u>John Henry Brass</u> (Name) <u>Asphew Miss</u> (Address)	<u>Bro @</u> <u>water sand</u>	<u>0</u> <u>35</u>	<u>35</u> <u>48</u>
(2) Location: <u>1/4</u> , <u>1/4</u> , Sec. <u> </u> T <u> </u> R <u> </u>			
<u>2</u> miles <u>N</u> , of <u>Crenshaw</u> (distance) (direction) (Nearest Town)			
(3) Topography: <input checked="" type="checkbox"/> (Hilly) <input type="checkbox"/> (Flat) <input type="checkbox"/> (Level)			
(4) Purpose of Well: <u> </u> (Domestic Irrigation Municipal, Industrial, Other)			
Information upon completion of well:			
(1) Diameter <u>2</u> inches.			
(2) Total Depth <u>48</u> feet.			
(3) Water Level <u>15</u> feet below top of ground.			
(4) Cased to <u>48</u> , Size <u>2</u>			
(5) Screen: Size <u>1 1/4</u> , Length <u>6</u>			
(6) Were any formations sealed against pollution?			
<u> </u> yes, <u> </u> no.			
If YES depth of formation <u> </u>			
Why <u> </u>			
Drillers Remarks: <u> </u>			
<u> </u> <u> </u> <u> </u>			

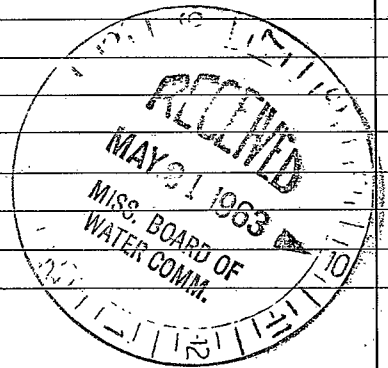

(Use Back Side)

Well No.

