

PANOLA

MISSISSIPPI BOARD OF WATER COMMISSIONERS

A

5-18-63

WATER WELL DRILLERS LOG

Date: 5-18, 1963 Driller: J B Cain County: Panola

(Name)

(1) Owner of Land:	Description & Color of Materials Sand, Clay, Red Clay, Shell, etc.	Thick- ness Feet	Depth Feet
Joe Barlow (Name)	Bgs of Sand	0 40	40 68
(Address)			
(2) Location: 1/4, 1/4, Sec. T. R.			
2 miles N of Crunshaw (distance) (direction) (Nearest Town)			
(3) Topography: <input checked="" type="checkbox"/> (Hilly) (Flat) (Level)			
(4) Purpose of Well: _____ (Domestic Irrigation Municipal, Industrial, Other)			


Information upon completion of well:

- (1) Diameter 2 inches.
- (2) Total Depth 68 feet.
- (3) Water Level 47 feet below top of ground.
- (4) Cased to 68, Size 2
- (5) Screen: Size 1/4, Length 6
- (6) Were any formations sealed against pollution?
_____ yes, _____ no.

If YES depth of formation _____

Why _____

Drillers Remarks: _____

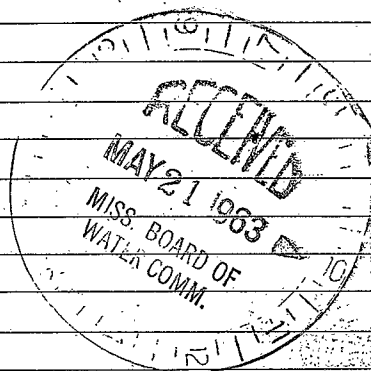

(Use Back Side)

Well 1

0. SIVA