

A

6-23-63

WATER WELL DRILLERS LOG

Date: 6-23, 1963, Driller: J B Carr County Panola

(Name)

(1) Owner of Land: <u>AH Hill</u> (Name)	Description & Color of Materials Sand, Clay, Red Clay, Shell, etc.	Thick- ness Feet	Depth Feet
<u>Crenshaw</u> (Address)	<u>Clay</u>	<u>0</u>	<u>40</u>
(2) Location: <u>1/4</u> , <u>1/4</u> , Sec. <u>    </u> T. <u>    </u> R. <u>    </u> <u>5</u> miles <u>NE</u> of <u>Crenshaw</u> (distance) (direction) (Nearest Town)	<u>Land</u>	<u>40</u>	<u>90</u>
(3) Topography: <input checked="" type="checkbox"/> (Hilly) <input type="checkbox"/> (Flat) <input type="checkbox"/> (Level)	<u>Blue</u>	<u>190</u>	<u>220</u>
(4) Purpose of Well: <u>Home</u> (Domestic Irrigation Municipal, Industrial, Other)	<u>Land</u>	<u>220</u>	<u>257</u>



Information upon completion of well:

- (1) Diameter: 2 inches.
- (2) Total Depth: 257 feet.
- (3) Water Level: 142 feet below top of ground.
- (4) Cased to: 257, Size 2"
- (5) Screen: Size 1/4, Length 6 FT
- (6) Were any formations sealed against pollution?  
     yes,      no.

If YES depth of formation \_\_\_\_\_

Why \_\_\_\_\_

Drillers Remarks: \_\_\_\_\_

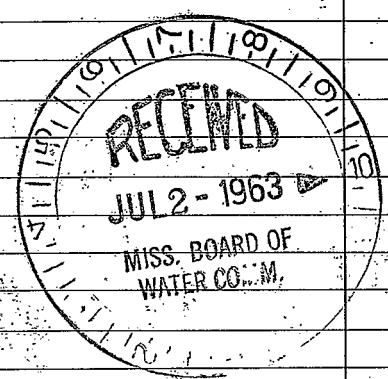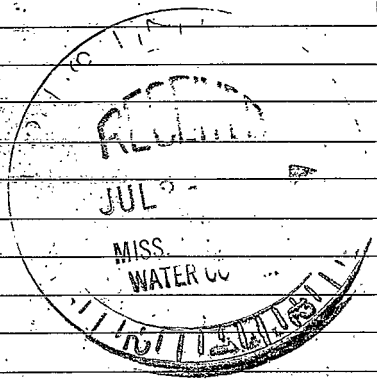

(Use Back Side)

Well No.

