

PANOLA

MISSISSIPPI BOARD OF WATER COMMISSIONERS

A

WATER WELL DRILLERS LOG

1-20-64

Date: 1-20, 1964, Driller: J B Cain County Panola

(Name)

(1) Owner of Land: Jim Turner (Name)
Camo Miss (Address)

(2) Location: 1/4, 1/4, Sec. T R
13 miles West of Camo (distance) (direction) (Nearest Town)

(3) Topography: (Hilly) (Flat) (Level)

(4) Purpose of Well: Hand (Domestic Irrigation Municipal, Industrial, Other)

Table with 3 columns: Description & Color of Materials, Thickness Feet, Depth Feet. Rows include Clay, Gravel, Blue cl, Fine sand, Blue cl, Sand.


Information upon completion of well:

- (1) Diameter 4 inches.
(2) Total Depth 316 feet.
(3) Water Level 170 feet below top of ground.
(4) Cased to 300, Size 7 1/2"
(5) Screen: Size 20, Length 10
(6) Were any formations sealed against pollution?
yes, no.

If YES depth of formation

Why

Drillers Remarks: This is a Plastic well

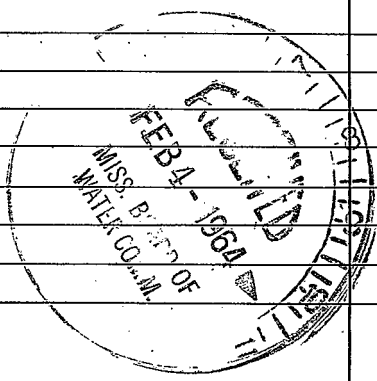

(Use Back Side)

Well No.

