

A
10-20-64

WATER WELL DRILLERS LOG

Date: 10-20, 1964, Driller: J B CAIN County: Panola

(Name)

(1) Owner of Land: Clide Lambert
(Name)
Como Miss
(Address)

(2) Location: 1/4, 1/4, Sec. T R
12 miles W of Como
(distance) (direction) (Nearest Town)

(3) Topography: (Hilly) (Flat) (Level)

(4) Purpose of Well: Home
(Domestic Irrigation, Municipal, Industrial, Other)

Description & Color of Materials Sand, Clay, Red Clay, Shell, etc.	Thick- ness Feet	Depth Feet
<u>Clay</u>	<u>0</u>	<u>60</u>
<u>Clay</u>	<u>60</u>	<u>110</u>
<u>Clay</u>	<u>110</u>	<u>140</u>
<u>Sand</u>	<u>140</u>	<u>170</u>


Information upon completion of well:

- (1) Diameter 4 inches.
- (2) Total Depth 170 feet.
- (3) Water Level 108 feet below top of ground.
- (4) Cased to 170, Size 4"
- (5) Screen: Size 2", Length 5 FT
PLASTIC well
- (6) Were any formations sealed against pollution?
 yes, no.

If YES depth of formation

Why

Drillers Remarks: Plastic
Screen Traveled
in 10 Sal
Per ~~Handwritten~~ M

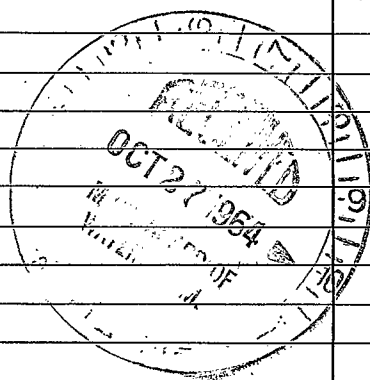

(Use Back Side)

Well No.

The first part of the document discusses the importance of maintaining accurate records of all transactions. It emphasizes that every entry should be supported by a valid receipt or invoice. This ensures transparency and allows for easy verification of the data.

In addition, the document outlines the procedures for handling discrepancies. If there is a difference between the recorded amount and the actual amount, it is crucial to investigate the cause immediately. This could be due to a clerical error, a missing receipt, or a change in the underlying data.

The document also provides guidelines for the storage and security of financial records. All records should be stored in a secure, fireproof location. Regular backups should be performed to prevent data loss. Access to the records should be restricted to authorized personnel only.

Furthermore, the document discusses the importance of regular audits. Audits help to identify any irregularities or errors in the records. They also provide an opportunity to review the internal controls and make necessary adjustments to improve the accuracy and reliability of the financial reporting process.

Finally, the document concludes by stating that maintaining accurate financial records is essential for the success of any business. It provides a clear framework for how to manage financial data effectively and ensure compliance with all relevant regulations.