

Panola  
A3  
9-66

MISSISSIPPI BOARD OF WATER COMMISSIONERS

WATER WELL DRILLERS LOG **CODED**

Date: Sept 17, 1966, Driller: Shelby Keyman County Panola  
Mrs & Mrs D. M. (Name)

(1) Owner of Land:	Description & Color of Materials	Thick-ness Feet	Depth Feet
<u>Asheville</u> (Name) <u>Mills</u> (Address)	<u>Red Clay</u>	<u>10</u>	<u>10</u>
(2) Location: <u>NW 1/4, NW 1/4, Sec. 30 T6R9</u>	<u>Red Clay</u>	<u>20</u>	<u>30</u>
<u>2</u> miles <u>N</u> of <u>Crenshaw</u> (Nearest Town)	<u>Sand</u>	<u>20</u>	<u>50</u>
(3) Topography: <u>Flat</u> (Hilly) (Flat) (Level)	<u>Blue Clay</u>	<u>50</u>	<u>100</u>
(4) Purpose of Well: <u>Domestic</u> (Domestic Irrigation, Municipal, Industrial, Other)	<u>Mixture of Blue Clay &amp; Sand</u>	<u>12</u>	<u>112</u>
	<u>White Sand</u>		


Information upon completion of well:

- (1) Diameter 2 inches.
- (2) Total Depth 112 feet.
- (3) Water Level 40 feet below top of ground.
- (4) Cased to 105, Size 2 in.
- (5) Screen: Size 90, Length 6 ft.
- (6) Were any formations sealed against pollution?  
no yes, no no.

If YES depth of formation \_\_\_\_\_  
Why \_\_\_\_\_

Drillers Remarks: \_\_\_\_\_

**CODED**

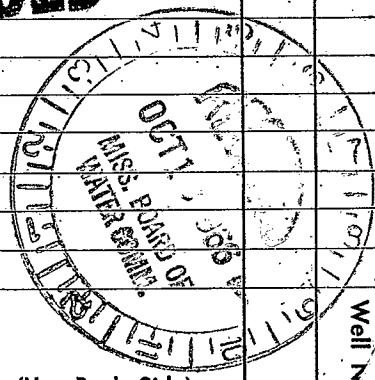

(Use Back Side)

