

Patrol
A-5
11-6-79

MISSISSIPPI
 BOARD OF WATER COMMISSIONERS
 416 North State Street
 Jackson, Mississippi 39201

CODED

WATER WELL DRILLERS LOG

11-6-79 date well completed 1979 AB Co Patrol well located
159 Stream

LANDOWNER: <u>Pharmacy Builders</u>	description of formations encountered	from	to
Company			
<u>Cranshaw Miss.</u> (mailing address)	<u>Gravel</u>	<u>0</u>	<u>18</u>
	<u>Sand</u>	<u>18</u>	<u>110</u>

WELL LOCATION:
 sec. 31 T 6 N R 9 E
City S W
 (distance) miles (direction) of Cranshaw (nearest town)

WELL PURPOSE: PLANT
 (home, irrigation, municipal, industrial)

- WELL COMPLETION DATA:
- (1) diameter (inches) 6
 - (2) total depth (feet) 110
 - (3) static water level (feet) 11' ^{below} top of ground.
 - (4) casing Plastic, 110
 (material) (depth)
 (size) if telescope see back.
 - (5) screen 20, 90
 (length) (depth to top)
4", Plastic
 (size) (material)
 - (6) pump 5, 100
 (HP) (yield gpm)
Elect 3 Phase
 (type power)
 - (7) electric log NO
 (yes or no)
 - (8) how well bottom plugged Work Bottom
 (organization running log)

DRILLERS REMARKS:


DEPT. OF NATURAL RESOURCES
 BUREAU OF LAND & WATER RESOURCES

NOV - 9 1979

RECEIVED

If well telescopes please sketch and show depths.

GROUND LEVEL

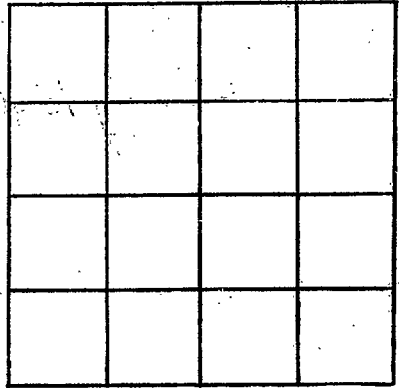

SECTION _____

Please indicate well location X.

ADDITIONAL INFORMATION

If more than one screen, show locations of each on sketch.