

GW02410

Panola
A23

MISSISSIPPI
BOARD OF WATER COMMISSIONERS
416 North State Street
Jackson, Mississippi 39201

CODED

11-15-66

M.G.S.

WATER WELL DRILLERS LOG

11/15/66

Bailey Drlg. Co.

Panola

date well completed

firm name

county well located

LANDOWNER:

A.S. Water Assn

Description of formations encountered

from

to

Crenshaw

Clay

0

20

Miss. at Longtown
(mailing address)

Sand

20

45

Gravel

45

60

Mud

60

240

WELL LOCATION:

34 ~~35~~ T 6 S R 9 E

4 miles E of Crenshaw

(distance) (direction) (nearest town)

Sand

240

287

Mud

287

370

Sand

370

420

Rock

420

421

Mud

421

461

WELL PURPOSE:

Community

(home, irrigation, municipal, industrial)

Sand

461

525

Rock

525

526

WELL COMPLETION DATA:

(1) diameter (inches)

8 x 4

(2) total depth (feet)

1500

(3) static water level (feet)

190 below top of ground.

(4) casing

Steel

(material) (depth)

8 x 4 (size)

if telescope see back.

(5) screen

40' 1460'

(length) (depth to top)

4" stainless steel

(size) (material)

(6) pump

25 150

(HP) (yield gpm)

Electric

(type power)

(7) electric log

yes

(yes or no)

Miss. Geo. Survey

(organization running log)

(8) how well bottom plugged

back pressure valve

DRILLERS REMARKS:

APR 15 1969

MISS. DE. OF WATER CONTROL


If well telescopes please sketch and show depths.

GROUND LEVEL

1162' 8" pipe

1035' 11 pipe
 capped 11' into
 8"

110' strainer

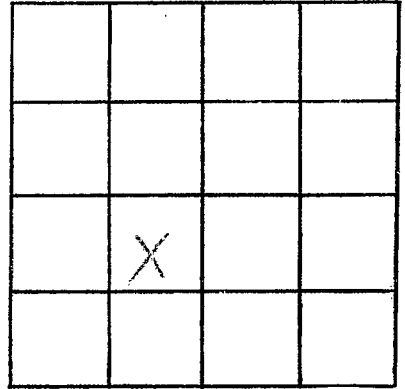

SECTION 211

Please indicate well location X.

ADDITIONAL INFORMATION

If more than one screen, show locations of each on sketch.