

ELOG #28

MISSISSIPPI
BOARD OF WATER COMMISSIONERS
416 North State Street
Jackson, Mississippi 39201

C 2538

WATER WELL DRILLERS LOG

CODED

November 9, 1967 Layne-Central Company Panola
date well completed firm name county well located

LANDOWNER: Miss Frances Schley

description of formations encountered

from to

Sledge, Mississippi
(mailing address)

Top soil	0	6
Red clay	6	16
Gravel & sand	16	86
Clay	86	150
Sandy clay & shell	150	170
Sand & shell	170	193
White coarse sand	193	300
Clay	300	307
Coarse sand	307	469
Clay	469	529
Rock	529	530
Clay	530	579
Clay with strks. sand	579	645
Sandy clay and lignite	645	744
Sand with clay strks.	744	879
Rock	879	880
Clay	880	919
Clay with sand strks.	919	965
Rock	965	966
Sandy clay	966	975
Sand	975	1060
Clay	1060	1138
Sand with clay strks.	1138	1200
Clay	1200	1324
Rock	1324	1325
Clay	1325	1525
Rock	1525	1526
Sand	1526	1588

WELL LOCATION:

sec 32 T 6 N R 9 E
⑤ East ⑥ W
2 miles west of Crenshaw
(distance) (direction) (nearest town)


WELL PURPOSE: home
(home, irrigation, municipal, industrial)

WELL COMPLETION DATA:

- (1) diameter (inches) 6x4x3
- (2) total depth (feet) 1588
- (3) static water level (feet) 149 below top of ground.
- (4) casing steel, 1552' *
(material) (depth)
- 6", 4" & 3" if telescope see back.
(size)
- (5) screen 30', 1582'
(length) (depth to top)
- 3", stainless steel
(size) (material)
- (6) pump 3.3 30
(HP) (yield gpm)
- electric
(type power)
- (7) electric log no
(yes or no)
- (organization running log)
- (8) how well bottom plugged lead shot

DRILLERS REMARKS:

* Casing: 99' 10" of 6",
212' of 4" & 1257' of 3",
having 16' 10" lap.

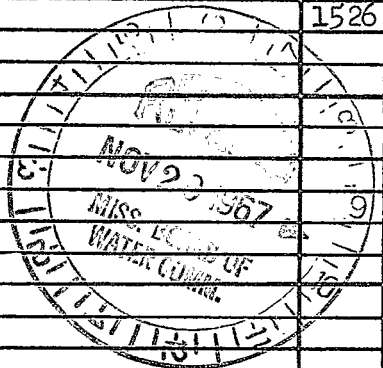

If well telescopes please sketch and show depths.

GROUND LEVEL

			X

SECTION 32

Please indicate well location X.

ADDITIONAL INFORMATION

If more than one screen,
show locations of each on sketch.