

PANOLA

MISSISSIPPI BOARD OF WATER COMMISSIONERS

A 25

WATER WELL DRILLERS LOG

CODED

11-16-62

Date: 11-16, 1962, Driller: James R. Lips County Panola

(Name)

(1) Owner of Land Wm Beeford

(Name)

Crenshaw, Miss.

(Address)

(2) Location: 1/4, 1/4, Sec 26 T6 S9 R11W

1.5 miles West of Sardis

(distance)

(direction)

(Nearest Town)

(3) Topography: Hilly

(Hilly)

(Flat)

(Level)

(4) Purpose of Well: Domestic

(Domestic Irrigation, Municipal, Industrial, Other)

Description & Color of Materials
Sand, Clay, Red Clay, Shell, etc.

Thick-
ness
Feet

Depth
Feet

Sand	0	50
sand & clay	50	85
Black clay	85	110
gravel & sand	110	150
W/peeling sand	150	198

Information upon completion of well:

(1) Diameter 2" inches.

(2) Total Depth 198' feet.

(3) Water Level 130' feet below top of ground.

(4) Cased to 190', Size 2"

(5) Screen: Size 1/4", Length 6'

(6) Were any formations sealed against pollution?


yes, no.

If YES depth of formation

Why

Drillers Remarks:

CODED

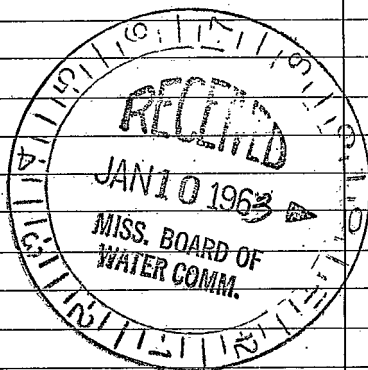

(Use Back Side)

Well No.

