

A
5-10-62

WATER WELL DRILLERS LOG

A-300

Date: 5-10, 1962, Driller: J B Cain County Panola

(Name)

(1) Owner of Land: H M Nelson
(Name)
Crenshaw Miss
(Address)
Location: Dont know what sec
1/4, 1/4, Sec. T R
6 miles N.E. of Crenshaw
(distance) (direction) (Nearest Town)

(3) Topography: (Hilly) (Flat) (Level)

(4) Purpose of Well: Home
(Domestic Irrigation
Municipal, Industrial, Other)

Description & Color of Materials Sand, Clay, Red Clay, Shell, etc.	Thick- ness Feet	Depth Feet
<u>Bro of</u>	<u>0</u>	<u>60</u>
<u>Gravel</u>	<u>60</u>	<u>78</u>
<u>Blue Clay</u>	<u>78</u>	<u>210</u>
<u>Sand</u>	<u>210</u>	<u>260</u>

Information upon completion of well:

(1) Diameter 2 inches.

(2) Total Depth 260 feet.

(3) Water Level 140 feet below top of ground.


(4) Cased to 260, Size 2"

(5) Screen: Size 1 1/4, Length 6 FT

(6) Were any formations sealed against pollution?
_____ yes, _____ no.

If YES depth of formation _____
Why _____

Drillers Remarks: Didn't Have
Map of this Country
Dont Know
what Sect

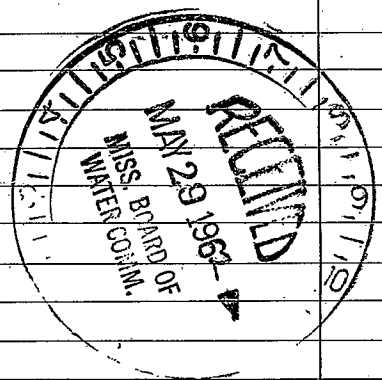

(Use Back Side)

Well No.

