

MISSISSIPPI  
BOARD OF WATER COMMISSIONERS  
416 North State Street  
Jackson, Mississippi 39201

WATER WELL DRILLERS LOG

Panola  
A 1001

4 20 1983 Big Stream PANOLIA  
date well completed firm name county well located

LANDOWNER: Phumley Ruler  
  
(mailing address)  
  
WELL LOCATION:  
sec. 6 T-6 N R-9 E  
SW W  
1/2 miles N of OREA  
(distance) (direction) (nearest town)

description of formations encountered	from	to
<u>Blue Clay</u>	<u>0</u>	<u>20</u>
<u>Sand S</u>	<u>20</u>	<u>70</u>
<u>Sand + M</u>	<u>70</u>	<u>110</u>

WELL PURPOSE:  
(home, irrigation, municipal, industrial)

WELL COMPLETION DATA:  
 (1) diameter (inches) 6"  
 (2) total depth (feet) 110  
 (3) static water level (feet) 15 below above top of ground.  
 (4) casing PLAST 80  
       (material) (depth)  
6"  
       (size) If telescope see back.  
 (5) screen 30 80  
       (length) (depth to top)  
4 PLASTIC  
       (size) (material)  
 (6) pump 10 HP 210  
       (HP) (yield gpm)  
3 Phase Currit  
       (type power)  
 (7) electric log NO  
       (yes or no)  
 \_\_\_\_\_  
 (organization running log)  
 (8) how well bottom plugged CAP

DRILLERS REMARKS:


DEPT. OF NATURAL RESOURCES  
BUREAU OF LAND & WATER RESOURCES

MAY 23 1983

RECEIVED

If well telescopes please sketch and show depths.

GROUND LEVEL

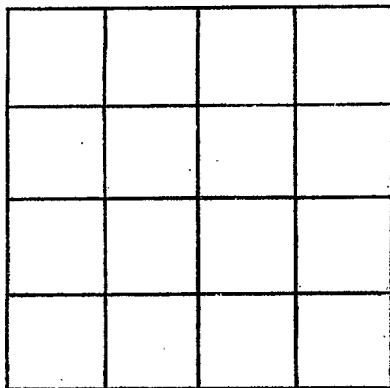

SECTION \_\_\_\_\_

Please indicate well location X.

ADDITIONAL INFORMATION

If more than one screen, show locations of each on sketch.