

Panola
A 200
1-22-76

MISSISSIPPI
 BOARD OF WATER COMMISSIONERS
 416 North State Street
 Jackson, Mississippi 39201

WATER WELL DRILLERS LOG

1-22 ¹⁵⁶ Hicks well co PANOLA
 date well completed firm name county well located

LANDOWNER: LARRY RAINES
CRENSHAW MISS
 (mailing address)


description of formations encountered	from	to
	<u>Red Clay</u>	<u>0</u>
<u>11 sand</u>	<u>10</u>	<u>60</u>
<u>Clay & gravel</u>	<u>60</u>	<u>200</u>
<u>wellbore sand</u>	<u>200</u>	<u>240</u>

WELL LOCATION:
 sec. 33 T. 6 N. R. 9 E
1 miles EAST of CRENSHAW
 (distance) (direction) (nearest town)

WELL PURPOSE: Home
 (home, irrigation, municipal, industrial)

- WELL COMPLETION DATA:
- (1) diameter (inches) 2 1/2"
 - (2) total depth (feet) 240
 - (3) static water level (feet) 80 below above top of ground.
 - (4) casing PVC, 240
 (material) (depth)
 (size) If telescope see back.
 - (5) screen 7', 7'
 (length) (depth to top)
 (size) (material)
 - (6) pump 3/4, 10
 (HP) (yield gpm)
220 Elec
 (type power)
 - (7) electric log No
 (yes or no)
 (organization running log)
 - (8) how well bottom plugged Caps

DRILLERS REMARKS:

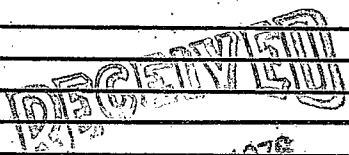


FEB 18 1976

MISS. BD. OF WATER COM. AT

If well telescopes please sketch and show depths.

GROUND LEVEL

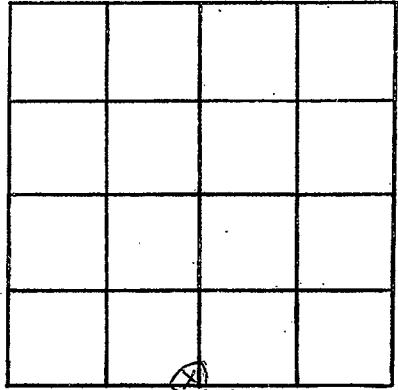

SECTION 33

Please indicate well location X.

ADDITIONAL INFORMATION

If more than one screen,
show locations of each on sketch.