

MISSISSIPPI DEPARTMENT OF NATURAL RESOURCES

Bureau of Land and Water Resources

Southport Mall

P.O. Box 10631

Jackson, Mississippi 39209

WATER WELL DRILLERS LOG

Panola
A
2002

11/22 1983
date well completed

HICKS WELL CO.
Drill Bits, etc.
firm name
Seminole, Mo 66668

Panola
county well located

LANDOWNER: Scot Saldon
Rt. 1 Box 210A
Sarah, Mo. 38665
(mailing address)

description of formations encountered	from to	
	ft	ft
Red Clay	0	20
Red sand & gravel	20	50
white clay & gravel	50	100
Black Clay	100	245
white sand	245	275

WELL LOCATION:
sec. 23 T 6 N R 9 E
miles (distance) (direction) of Cooper Corner (nearest town)

WELL PURPOSE: None
(home, irrigation, municipal, industrial)

WELL COMPLETION DATA:

(1) diameter (inches) 4

(2) total depth (feet) 275

(3) static water level (feet) 170 below above top of ground.

(4) casing PVC 275'
(material) (depth)
4" If telescope-see back.
(size)

(5) screen 10' 265'
(length) (depth to top)
8/10" PVC
(size) (material)

(6) pump 3/4 18
(HP) (yield gpm)

220V
(type power)

(7) electric log No
(yes or no)

(organization running log)

(8) how well bottom plugged Cap

DRILLERS REMARKS:


DEPT. OF NATURAL RESOURCES
BUREAU OF LAND & WATER RESOURCES

JAN 9 1984

RECEIVED

If well telescopes please sketch and show depths.

GROUND LEVEL

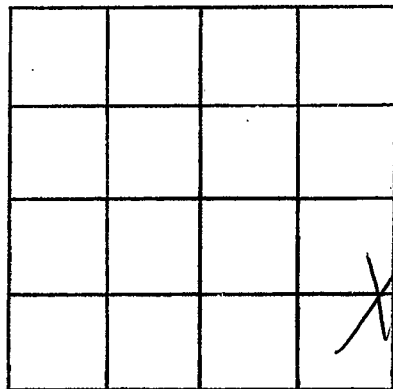

SECTION 23

Please indicate well location X.

ADDITIONAL INFORMATION

If more than one screen,
show locations of each on sketch.