

PANOLA
A 2004

MISSISSIPPI DEPARTMENT OF NATURAL RESOURCES
Bureau of Land and Water Resources
Southport Mall
P.O. Box 10631
Jackson, Mississippi 39209
WATER WELL DRILLERS LOG

3-19-1991 LIFE WELL & SUPPLY CO. INC. PANOLA
date well completed firm name county well located

LANDOWNER: Tommy Florence
Rt. 1
Courtland, Ms. 38620
(mailing address)

WELL LOCATION:
sec. 25 T-6 N R-9 E
8 1/2 miles W of Como
(distance) (direction) (nearest town)

WELL PURPOSE: FERTN
(home, irrigation, municipal, industrial)

WELL COMPLETION DATA:

- (1) diameter (inches) 4
- (2) total depth (feet) 220
- (3) static water level (feet) _____ below above top of ground.
- (4) casing PVC 210
(material) (depth)
4 if telescope see back.
(size)
- (5) screen 10 210
(length) (depth to top)
4 PVC
(size) (material)
- (6) pump 2 _____
(HP) (yield gpm)

(type power)
- (7) electric log _____
(yes or no)

(organization running log)
- (8) how well bottom plugged Capped

description of formations encountered	from	to
Top soil - soft clay	0	20
Soft clay	20	40
Soft clay - breaks red sand	40	60
Sand	60	80
Sand - pea gravel	80	100
PEA gravel	100	120
PEA gravel - sand	120	140
Sand - gravel - sand-clay mix	140	160
Sand - clay mix - clay - sand	160	180
Sand - clay mixed - sand	180	200
Sand	200	220

RECEIVED


APR 16 1991

Dept. of Environmental Quality
Bureau of Land & Water Resources

DRILLERS REMARKS:

If well telescopes please
sketch and show depths.

GROUND LEVEL

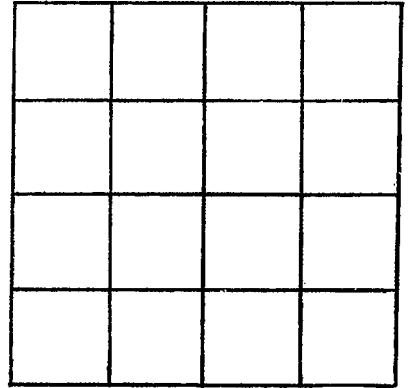

SECTION _____

Please indicate well location X.

ADDITIONAL INFORMATION

If more than one screen,
show locations of each on sketch.