

MISSISSIPPI DEPARTMENT OF NATURAL RESOURCES
Bureau of Land and Water Resources
 Southport Mall
 P.O. Box 10631
 Jackson, Mississippi 39209
WATER WELL DRILLERS LOG

PANOLA
A 2005

3-21 1991 Life Well & Supply Co. Inc. PANOLA
 date well completed firm name county well located

LANDOWNER: JAMES JOHNSON
Rt. 1 Box 157
Como, Ms. 38619
 (mailing address)

WELL LOCATION:
 sec. 36 T 6 N R 9 E
8 miles W of Como
 (distance) (direction) (nearest town)

WELL PURPOSE: HOME
 (home, irrigation, municipal, industrial)

WELL COMPLETION DATA:

- (1) diameter (inches) 4
- (2) total depth (feet) 207
- (3) static water level (feet) _____ below
 top of ground. above
- (4) casing PVC, 197
 (material) (depth)
4 if telescope see back.
 (size)
- (5) screen 10, 197
 (length) (depth to top)
4, PVC
 (size) (material)
- (6) pump 3/4, _____
 (HP) (yield gpm)

 (type power)
- (7) electric log _____
 (yes or no)

 (organization running log)
- (8) how well bottom plugged Capped

description of formations encountered	from	to
<u>Top soil, clay</u>	<u>0</u>	<u>20</u>
<u>clay, red sand</u>	<u>20</u>	<u>40</u>
<u>Red sand streaks of clay, streak gravel</u>	<u>40</u>	<u>60</u>
<u>pea gravel</u>	<u>60</u>	<u>80</u>
<u>gravel</u>	<u>80</u>	<u>100</u>
<u>gravel, little sand at bottom</u>	<u>100</u>	<u>120</u>
<u>sand, clay sand mix back to sand</u>	<u>120</u>	<u>140</u>
<u>sand clay mix</u>	<u>140</u>	<u>160</u>
<u>sand, clay mixed, sand at bottom</u>	<u>160</u>	<u>180</u>
<u>sand</u>	<u>180</u>	<u>200</u>
	<u>200</u>	<u>207</u>

RECEIVED


APR 16 1991

Dept. of Environmental Quality
 Bureau of Land & Water Resources

DRILLERS REMARKS: _____

If well telescopes please sketch and show depths.

GROUND LEVEL

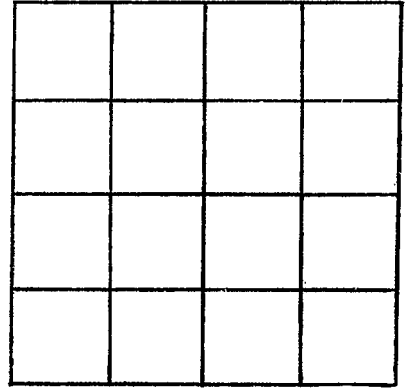

SECTION _____

Please indicate well location X.

ADDITIONAL INFORMATION

If more than one screen,
show locations of each on sketch.