

PANOLA
A2006

MISSISSIPPI DEPARTMENT OF NATURAL RESOURCES
Bureau of Land and Water Resources
Southport Mall
P.O. Box 10631
Jackson, Mississippi 39209
WATER WELL DRILLERS LOG

3-28-91 date well completed 1991 LIFE WELL + SUPPLY CO. INC. firm name PANOLA county well located

LANDOWNER: JAMES JOHNSON
Rt. 1 Box 157
Como, Ms. 38619
(mailing address)

WELL LOCATION:
sec. 36 T. 6 N R. 9 E
8 miles W of Como
(distance) (direction) (nearest town)

WELL PURPOSE: HOME
(home, irrigation, municipal, industrial)

WELL COMPLETION DATA:

- (1) diameter (inches) 4
- (2) total depth (feet) 190
- (3) static water level (feet) _____ below above top of ground.
- (4) casing PVC 180
(material) (depth)
4 if telescope see back.
(size)
- (5) screen 10 180
(length) (depth to top)
4 PVC
(size) (material)
- (6) pump 3/4 _____
(HP) (yield gpm)
(type power)
- (7) electric log _____
(yes or no)
(organization running log)
- (8) how well bottom plugged Capped

| description of formations encountered | from | to |
|--|------|-----|
| Top soil - clay | 0 | 20 |
| clay - red sand | 20 | 40 |
| red sand - streaks of clay, pea gravel | 40 | 60 |
| pea gravel | 60 | 80 |
| pea gravel - rock ss. gravel sand | 80 | 100 |
| | 100 | 120 |
| | 120 | 140 |
| clay - sand streaks of clay | 140 | 160 |
| sand - streaks of clay | 160 | 180 |
| sand | 190 | 200 |


REGISTERED
APR 16 1991

Dept. of Environmental Quality
Bureau of Land & Water Resources

DRILLERS REMARKS:

If well telescopes please sketch and show depths.

GROUND LEVEL

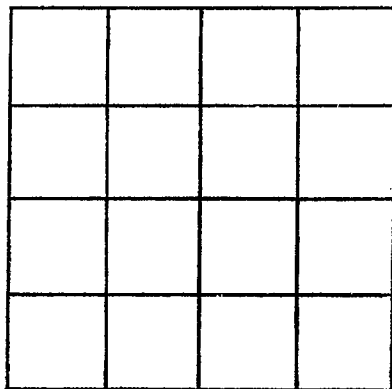

SECTION _____

Please indicate well location X.

ADDITIONAL INFORMATION

If more than one screen,
show locations of each on sketch.