

MISSISSIPPI DEPARTMENT OF ENVIRONMENTAL QUALITY

Office of Land and Water Resources

COUNTY WELL LOCATED
SNOWBIA

WELL NUMBER A 2008 CODED

DATE WELL COMPLETED
4-25-94

PERMIT NUMBER
HICKS WELL CO.

NAME OF DRILLING FIRM
**RT. 1 BOX 157
SENATOBIA, MS 38668**

P. O. Box 10631
Jackson, MS 39289-0631
WATER WELL DRILLERS LOG

NAME & MAILING ADDRESS OF LANDOWNER
Sheran Carter
RT 1 Box 221
SARAH MS

WELL LOCATION: SEC 26 TOWNSHIP 6 RANGE 9
N S E W

DISTANCE 10 Miles West NW of SARDIS

OTHER LANDMARK

WELL PURPOSE Home Irrigation, Municipal, Industrial, Fish Pond, etc.

PUMP DATA

PUMP TYPE (Circle One):
Submersible Turbine, Jet, Flowing Well,
Other (Describe)

POWER TYPE (Circle One):
Electric Tractor, Diesel, Gasoline, Butane,
Other (Describe) H/P 3/4

Pump Capacity (GPM) 10 No. of Stages Setting Depth 200 FT.

PUMP TEST

Well yielded _____ GPM with
a drawdown of _____ ft.
after _____ hours of pumping

WELL DATA

Well Depth 238' Casing Diameter (In.) 4" Casing Length (Ft.) 228'

Type of Casing PVC Hole Depth 238' Depth to Static Water Level 160'

TYPE OF COMPLETION: (Circle One or More):
Gravel Packed, Underreamed, Telescoped,
Natural Development, Open Hole, Other
(Describe)

WELL GROUTED TO A DEPTH OF 10 FEET
Type Grout (circle one): Cement, Bentonite, or Mix

LOG DATA

TYPE OF LOG RUN (Circle One):
No Log Run, Electric, Gamma Ray, Density, Sonic, Neutron,
Other (Describe)

Name of Organization Running Log

SCREEN DATA

Diameter - Inches 4" Length - Feet 10' Slot Size - Inches .013

Screen Type PVC Depth to Bottom - Feet 238

GEOLOGIC DATA (Office Use Only)

Surface Elev.	Geologic Unit	Unit Thickness	Depth to Top
Subs. SWL	Date	Analysis	Aquifer Test

Driller's Remarks

Top of Lap Pipe or Reduction in Casing

FEET IF TELESOPED OR MORE THAN ONE SCREEN: USE BACK PAGE


DESCRIPTION OF FORMATIONS ENCOUNTERED	FROM	TO	FORMATIONS (Continued)	FROM	TO
<u>SAND & CLAY</u>	<u>0</u>	<u>80</u>	RECEIVED AUG 09 1994		
<u>CLAY</u>	<u>80</u>	<u>180</u>			
<u>White Sand</u>	<u>180</u>	<u>238</u>			

Dept. of Environmental Quality
Office of Land & Water Resources

IF MORE SPACE IS NEEDED, USE BACK

If well telescopes please sketch and show depths.

GROUND LEVEL

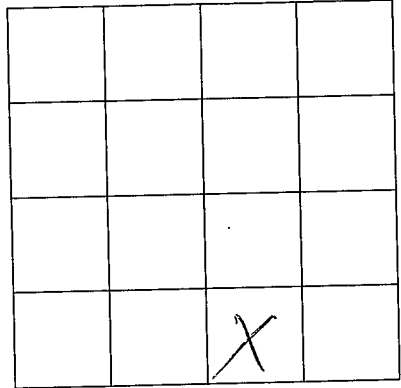

SECTION 26

Please indicate well location X.

ADDITIONAL INFORMATION

If more than one screen,
show location of each on sketch.