

B

11-24-65

WATER WELL DRILLERS LOG

Date: 11-24, 19 65, Driller: Gerry Robinson County Panola  
(Name)

(1) Owner of Land: Mr. Frank Stewart  
(Name)

Como, Miss.  
(Address)

(2) Location: 1/4, 1/4, Sec.     T.     R.    

4 miles W, of Como  
(distance) (direction) (Nearest Town)

(3) Topography:      
(Hilly) (Flat) (Level)

(4) Purpose of Well: tenant house  
(Domestic Irrigation  
Municipal, Industrial, Other)

Description & Color of Materials Sand, Clay, Red Clay, Shell, etc.	Thick- ness Feet	Depth Feet
<u>Clay</u>	<u>0</u>	<u>20</u>
<u>Sand &amp; Gravel</u>	<u>20</u>	<u>60</u>
<u>sand</u>	<u>60</u>	<u>110</u>

Information upon completion of well:

(1) Diameter 2 inches.

(2) Total Depth 110 feet.

(3) Water Level 45 feet below top of ground.

(4) Cased to 105, Size 2 in

(5) Screen: Size 1 1/4 in, Length 5 ft.

(6) Were any formations sealed against pollution?


    yes,     no.

If YES depth of formation    

Why    

Drillers Remarks: Steel well

Arched in screen

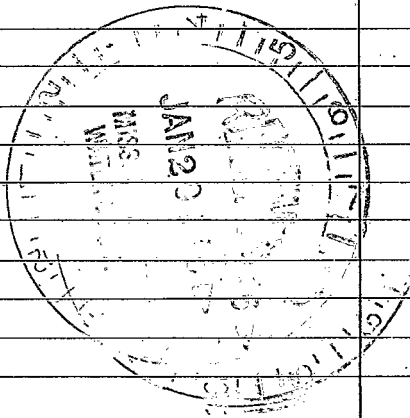

(Use Back Side)

Well No.

