

MISSISSIPPI
 BOARD OF WATER COMMISSIONERS
 416 North State Street
 Jackson, Mississippi 39201
 WATER WELL DRILLERS LOG

CODED

PANOLA
 B I
 3-25-71

19 3-25-71 Panola
 date well completed firm name county well located

LANDOWNER <u>MR EGDWAY</u>	description of formations encountered	from	to
<u>ORENSHAW MISS</u> (mailing address)			
	<u>Red cl</u>	<u>0</u>	<u>30</u>
	<u>Sand & Sta</u>	<u>30</u>	<u>100</u>
	<u>Sand</u>	<u>100</u>	<u>180</u>

WELL LOCATION:
 sec. 30 T 6 N 8 R 8 E W
 (distance) miles (direction) of (nearest town)

WELL PURPOSE:
 (home, irrigation, municipal, industrial)

WELL COMPLETION DATA:

- (1) diameter (inches) 4"
- (2) total depth (feet) _____
- (3) static water level (feet) 130 below above top of ground.
- (4) casing _____ (material) _____ (depth) _____
4" (size) If telescope see back.
- (5) screen 5 _____ (length) _____ (depth to top)
4" _____ (size) Plastic (material)
- (6) pump 3/4 _____ (HP) 10 _____ (yield gpm)
E (type power)
- (7) electric log _____ (yes or no)
 _____ (organization running log)
- (8) how well bottom plugged _____

CODED


APR - 6 1971

DRILLERS REMARKS:

MISS. BD. OF
 WATER COMM.

If well telescopes please sketch and show depths.

GROUND LEVEL

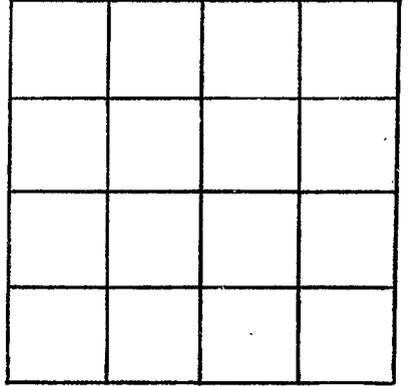

SECTION _____

Please indicate well location X.

ADDITIONAL INFORMATION

If more than one screen, show locations of each on sketch.