

PANOLA
B2
5-29-63

WATER WELL DRILLERS LOG **CODED**

Date: 5-29, 1963, Driller: aces of Independence County Panola
(Name Independence, Miss.)


(1) Owner of Land: Lamar Wilbourn
(Name)
Comd, Rte 2 Box 69
(Address) 2968

(2) Location: 1/4, 1/4, Sec. T R R
 miles of
(distance) (direction) (Nearest Town)

(3) Topography:
(Hilly) (Flat) (Level)

(4) Purpose of Well:
(Domestic Irrigation
Municipal, Industrial, Other)

Description & Color of Materials Sand, Clay, Red Clay, Shell, etc.	Thick- ness Feet	Depth Feet
<u>top soil</u>	<u>0</u>	<u>20</u>
<u>grey clay</u>	<u>20</u>	<u>27</u>
<u>granite shell</u>	<u>27</u>	<u>37</u>
<u>grey clay</u>	<u>37</u>	<u>121</u>
<u>red brown granite</u>	<u>121</u>	<u>153</u>

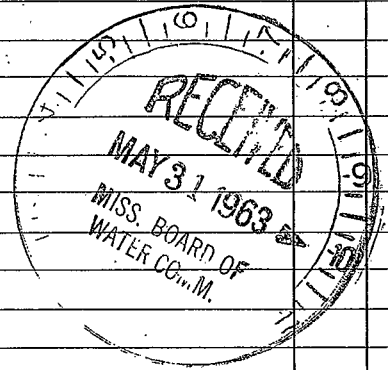

CODED

Information upon completion of well:

(1) Diameter 4 inches.

(2) Total Depth 153 feet.

(3) Water Level 80 feet below top of ground.

(4) Cased to 139, Size .

(5) Screen: Size 4", Length 14'.

(6) Were any formations sealed against pollution?
 yes, no.

If YES depth of formation .

Why .

Drillers Remarks:

Well No.

(Use Back Side)

