

PANOLA
B6
5-28-79

MISSISSIPPI
BOARD OF WATER COMMISSIONERS
416 North State Street
Jackson, Mississippi 39201

CODED

WATER WELL DRILLERS LOG

5-28 1979 Bob Smith & Son Panola
date well completed firm name county well located

LANDOWNER: Lavern Walters
Route 2, Box 82B
Como, Miss 38619
(mailing address)

description of formations encountered	from	to
Brown clay	0'	20'
Brown sand	20'	65'
Gravel	65'	80'
White clay	80'	120'
Bumbo	120'	190'
White sand	190'	250'


WELL LOCATION:
sec. 36 T. 6 N. R. 8 E
9 miles W of Como
(distance) (direction) (nearest town)

WELL PURPOSE: Home
(home, irrigation, municipal, industrial)

- WELL COMPLETION DATA:
- (1) diameter (inches) 4
 - (2) total depth (feet) 250
 - (3) static water level (feet) 132 below top of ground.
 - (4) casing Plastic, 250,
(material) (depth)
(size) if telescope see back.
 - (5) screen #10, 240
(length) (depth to top)
4, Plastic
(size) (material)
 - (6) pump 1/2, 10
(HP) (yield gpm)
Electric
(type power)
 - (7) electric log no.
(yes or no)
 - (8) how well bottom plugged plugged

DRILLERS REMARKS:


CODED

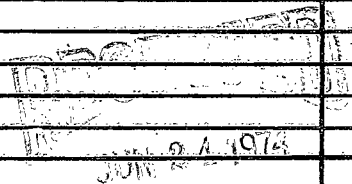

MISS. BD. OF WATER COMMISSIONERS

If well telescopes please sketch and show depths.

GROUND LEVEL

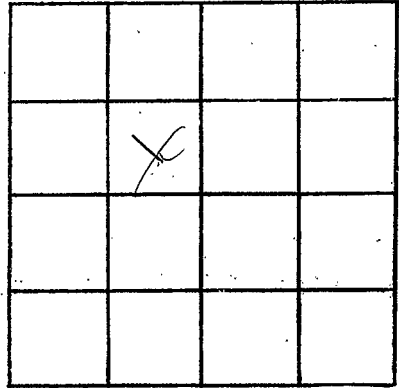

SECTION 36

Please indicate well location X.

ADDITIONAL INFORMATION

If more than one screen, show locations of each on sketch.