

PANOLA
B 7
1-29-73

MISSISSIPPI BOARD OF WATER COMMISSIONERS CODED
416 North State Street
Jackson, Mississippi 39201

WATER WELL DRILLERS LOG

1-29-1973 Bob Smith Panola
date well completed firm name county well located

LANDOWNER: Rachel Hollins
Como, Miss.
(mailing address)

description of formations encountered	from	to
<u>clay dirt</u>		<u>8</u>
<u>gravel</u>	<u>8</u>	<u>35</u>
<u>white sand</u>	<u>35</u>	<u>140</u>

WELL LOCATION:
sec. 25 T. 6 N. R. 8 E.
8 miles NW of Como
(distance) (direction) (nearest town)

WELL PURPOSE: None
(home, irrigation, municipal, industrial)

- WELL COMPLETION DATA:
- (1) diameter (inches) 4
 - (2) total depth (feet) 140
 - (3) static water level (feet) 49 below top of ground.
 - (4) casing Plastic, 140
(material) (depth)
(size) if telescope see back.
 - (5) screen 20, 120
(length) (depth to top)
4, Plastic
(size) (material)
 - (6) pump 1/3, 10
(HP) (yield gpm)
Edco
(type power)
 - (7) electric log no
(yes or no)
(organization running log)
 - (8) how well bottom plugged plugged


CODED

MISS. DR. OF WATER COMMISSIONERS
JULY 24 1974

DRILLERS REMARKS:

If well telescopes please sketch and show depths.

GROUND LEVEL

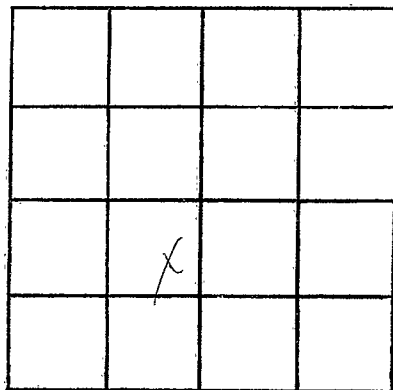

SECTION 25

Please indicate well location X.

ADDITIONAL INFORMATION

If more than one screen,
show locations of each on sketch.