

Panola
 B 10
 4-10-70

MISSISSIPPI
 BOARD OF WATER COMMISSIONERS
 416 North State Street
 Jackson, Mississippi 39201

CODED

WATER WELL DRILLERS LOG

April 10 1970 LIPE WELL CO. PANOLA
 date well completed firm name county well located

LANDOWNER:
 SANFORD E ROBERSON
 COMO, MISS
 (mailing address)

description of formations encountered	from	to
top soil & sand	0	20
sand	20	40
gravel	40	60
gravel	60	80
gravel	80	100
sand	100	120
sand	120	140
sand	140	160
sand	160	180
sand	180	200
sand	200	220

WELL LOCATION:
 sec. 19 T. 6 N. R. 8 E.
 11 miles W of Como
 (distance) (direction) (nearest town)

WELL PURPOSE: home
 (home, irrigation, municipal, industrial)

WELL COMPLETION DATA:

(1) diameter (inches) 4"

(2) total depth (feet) 216'

(3) static water level (feet) 100' below top of ground

(4) casing PVC, 206' (depth)
 4" if telescope see back. (size)

(5) screen 10' (length), 206' (depth to top)
 4" PVC & silica (size) (material)

(6) pump 3/4' (HP), 10 (yield gpm)
 elec (type power)

(7) electric log no (yes or no) ✓
 (organization running log)

(8) how well bottom plugged PVC cap

CODED


APR 20 1970

MISS. BD. OF WATER COMM.

DRILLERS REMARKS:

If well telescopes please sketch and show depths.

GROUND LEVEL

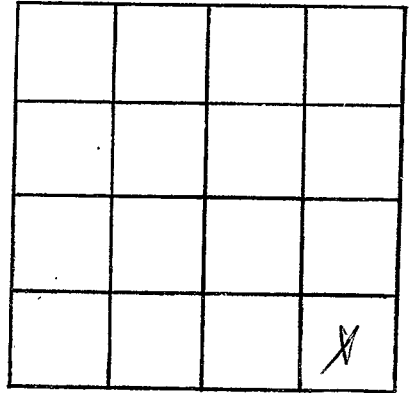

SECTION 19

Please indicate well location X.

ADDITIONAL INFORMATION

Lined area for additional information.

If more than one screen, show locations of each on sketch.