

PANOLA  
 B 203  
 2-2-77

MISSISSIPPI  
 BOARD OF WATER COMMISSIONERS  
 416 North State Street  
 Jackson, Mississippi 39201

WATER WELL DRILLERS LOG

2-3 1977 J B Cain Panola  
 date well completed firm name county well located

LANDOWNER: Pantini Taylor  
Como Main  
 (mailing address)  
 WELL LOCATION:  
 sec. 20 T 6 N W R 8 E  
7 miles W of Como  
 (distance) (direction) (nearest town)

description of formations encountered	from	to
Clay	0	30
Clay & Sand	30	50
Gravel	50	62
Clay	62	110
Sand	110	122
Clay	122	150
Sand	150	180

WELL PURPOSE: Home  
 (home, irrigation, municipal, industrial)

WELL COMPLETION DATA:  
 (1) diameter (inches) 4  
 (2) total depth (feet) 180  
 (3) static water level (feet) 82 <sup>below</sup> above top of ground.  
 (4) casing Rebar, 180  
 (material) (depth)  
 (size) if telescope see back.  
 (5) screen 10', 170  
 (length) (depth to top)  
4, Plastic  
 (size) (material)  
 (6) pump 3/4, 10  
 (HP) (yield gpm)  
Elect  
 (type power)  
 (7) electric log NO  
 (yes or no)  
 (organization running log)  
 (8) how well bottom plugged Plug


RECEIVED  
 FEB 14 1977

DRILLERS REMARKS:

MISS. BD. OF WATER COMMISSIONERS

If well telescopes please sketch and show depths.

GROUND LEVEL

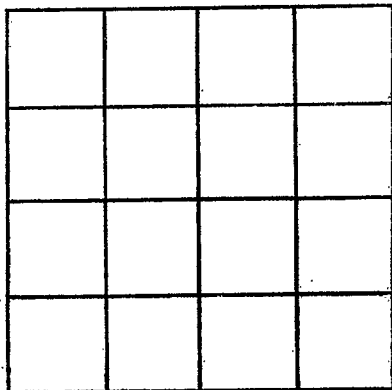

SECTION \_\_\_\_\_

Please indicate well location X.

ADDITIONAL INFORMATION

If more than one screen, show locations of each on sketch.