

PANOLA

B 2009

8/02/79

MISSISSIPPI BOARD OF WATER COMMISSIONERS
416 North State Street
Jackson, Mississippi 39201

WATER WELL DRILLERS LOG

8-2 19 79 Hicks Wedco. Panola
date well completed firm name county well located

LANDOWNER: Via Diddard

Description of formations encountered from to

B.E. Como
(mailing address)

clay 0 30
Black Clay 30 70
White Sand 70 140

WELL LOCATION:

sec 21 T 16 N R 8 E
4 miles West of Como
(distance) (direction) (nearest town)

WELL PURPOSE: Home
(home, irrigation, municipal, industrial)

WELL COMPLETION DATA:

- (1) diameter (inches) 4 in.
- (2) total depth (feet) 140 ft.
- (3) static water level (feet) _____ below above top of ground.
- (4) casing PLASTIC, 140,
(material) (depth)
_____ if telescope see back.
(size)
- (5) screen 7 ft., 133
(length) (depth to top)
4 in., galvanized
(size) (material)
- (6) pump 1/2 10
(HP) (yield gpm)
220
(type power)
- (7) electric log NO
(yes or no)

(organization running log)
- (8) how well bottom plugged cap

DRILLERS REMARKS:


Miss. Board of Water Comm.

AUG 27 1979

RECORDED

If well telescopes please sketch and show depths.

GROUND LEVEL

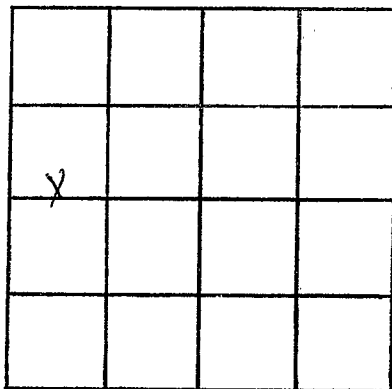

SECTION 21

Please indicate well location X.

ADDITIONAL INFORMATION

If more than one screen, show locations of each on sketch.