

PANOLA  
 B 2007  
 1-24-80

MISSISSIPPI  
 BOARD OF WATER COMMISSIONERS  
 416 North State Street  
 Jackson, Mississippi 39201

WATER WELL DRILLERS LOG

CODED  
 Panola

1-24 date well completed      19 80 Welch Well Co. firm name      Panola county well located

LANDOWNER:  
 Sammie Frost Jr.  
 Rt. 2, Coma Miss.  
 (mailing address)

description of formations encountered	from	to
White Clay	0	20
Red Sand	20	90
White Sand	90	140

WELL LOCATION:  
 sec. 26 T. 6 N. R. 8 E  
 1 1/2 miles W of Coma  
 (distance) (direction) (nearest town)

WELL PURPOSE: home  
 (home, irrigation, municipal, industrial)

- WELL COMPLETION DATA:
- (1) diameter (inches) 4 in
  - (2) total depth (feet) 140
  - (3) static water level (feet) 80 below top of ground
  - (4) casing Plastic 140 (material) (depth)
  - (size) if telescope see back.
  - (5) screen 7 ft 133 (length) (depth to top)  
 4 in (size) (material) gravel
  - (6) pump 1/2 10 (HP) (yield gpm)  
 220 (type power)
  - (7) electric log NO (yes or no)
  - (organization running log)
  - (8) how well bottom plugged Cap

DRILLERS REMARKS:


DEPT. OF NATURAL RESOURCES  
 BUREAU OF LAND & WATER RESOURCES

FEB 15 1980

RECEIVED

If well telescopes please sketch and show depths.

GROUND LEVEL

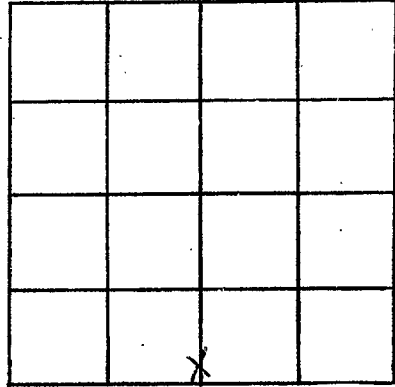

SECTION 26

Please indicate well location X.

ADDITIONAL INFORMATION

If more than one screen, show locations of each on sketch.