

Panola
3 2008
6-12-80
6-12

MISSISSIPPI
 BOARD OF WATER COMMISSIONERS
 416 North State Street
 Jackson, Mississippi 39201

WATER WELL DRILLERS LOG

date well completed

firm name

county well located

1980 Dicks Well Co. Panola

LANDOWNER:
Bobby Fields
Rt. 2, Cama
 (mailing address)

description of formations encountered	from	to
<u>Black clay</u>	<u>0</u>	<u>270</u>
<u>white sand</u>	<u>270</u>	<u>290</u>

WELL LOCATION:
 sec. 23 T. 6 N R. 8 E
4 miles W of Cama
 (distance) (direction) (nearest town)

WELL PURPOSE: home
 (home, irrigation, municipal, industrial)

WELL COMPLETION DATA:
 (1) diameter (inches) 4 in
 (2) total depth (feet) 290
 (3) static water level (feet) 140 below above top of ground.
 (4) casing Plastic 290
 (material) (depth)
 (size) if telescope see back.
 (5) screen 7 ft 283
 (length) (depth to top)
4 in Gravel
 (size) (material)
 (6) pump 1/2 10
 (HP) (yield gpm)
220
 (type power)
 (7) electric log No
 (yes or no)
 (organization running log)
 (8) how well bottom plugged Cap

DRILLERS REMARKS:


DEPT OF NATURAL RESOURCES
 BUREAU OF LAND & WATER RESOURCES

JUN 25 1980

RECEIVED

If well telescopes please sketch and show depths.

GROUND LEVEL

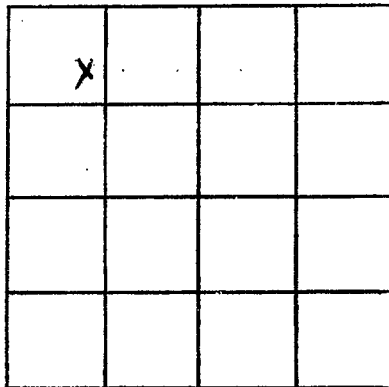

SECTION 23

Please indicate well location X.

ADDITIONAL INFORMATION

A series of horizontal lines for writing additional information, starting below the 'ADDITIONAL INFORMATION' header and extending to the bottom of the page.

If more than one screen, show locations of each on sketch.