

MISSISSIPPI DEPARTMENT OF NATURAL RESOURCES

Bureau of Land and Water Resources

Southport Mall

P.O. Box 10631

Jackson, Mississippi 39209

WATER WELL DRILLERS LOG

Panola  
B  
2009

9-11 1980 Bob Smith Panola  
 date well completed firm name county well located

LANDOWNER:

Grant Raymond  
Como, Miss.  
 (mailing address)

description of formations encountered

from to

<u>top soil</u>	<u>0</u>	<u>5</u>
<u>red clay</u>	<u>5</u>	<u>60</u>
<u>white clay</u>	<u>60</u>	<u>120</u>
<u>white sand</u>	<u>120</u>	<u>210</u>

WELL LOCATION:

sec 25 T 6 N R 8 E  
6 miles n.w. of Como  
 (distance) (direction) (nearest town)

WELL PURPOSE:

(home) (irrigation, municipal, industrial)

WELL COMPLETION DATA:

- (1) diameter (inches) 4"
- (2) total depth (feet) 210'
- (3) static water level (feet) 100' <sup>below</sup> <sub>above</sub> top of ground.
- (4) casing plastic 210'  
 (material) (depth)

\_\_\_\_\_ if telescope see back.  
 (size)

- (5) screen 20' 190'  
 (length) (depth to top)

4" plastic  
 (size) (material)

- (6) pump 1/2 10  
 (HP) (yield gpm)

plc.  
 (type power)

- (7) electric log (no)  
 (yes or no)

\_\_\_\_\_ (organization running log)

- (8) how well bottom plugged Cap

DRILLERS REMARKS:


DEPT. OF NATURAL RESOURCES  
 BUREAU OF LAND & WATER RESOURCES

OCT 12 1982

RECEIVED

If well telescopes please sketch and show depths.

GROUND LEVEL

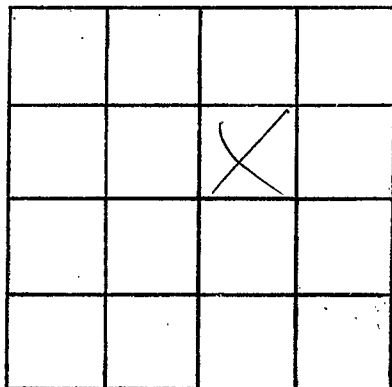

SECTION \_\_\_\_\_

Please indicate well location X.

ADDITIONAL INFORMATION

If more than one screen,  
show locations of each on sketch.