

Panola
B
2012

MISSISSIPPI
 BOARD OF WATER COMMISSIONERS
 416 North State Street
 Jackson, Mississippi 39201

WATER WELL DRILLERS LOG

4-22 1983 BIG STREAM PANOLA
 date well completed firm name county well located.

LANDOWNER: LARY JONES

description of formations encountered	from	to
<u>Brown Clay</u>	<u>0</u>	<u>60</u>
<u>Sandstone</u>	<u>60</u>	<u>90</u>
<u>Sand</u>	<u>90</u>	<u>120</u>

(mailing address)

WELL LOCATION:

sec. 24 T 6 N R 8 E
3 1/2 miles NW of COMO
 (distance) (direction) (nearest town)

WELL PURPOSE:

(home, irrigation, municipal, industrial)

WELL COMPLETION DATA:

- (1) diameter (inches) 4 1/2
- (2) total depth (feet) 120
- (3) static water level (feet) 80 below above top of ground.
- (4) casing PLAST 1 1/2
 (material) (depth)
4 if telescope see back.
 (size)
- (5) screen 10 110
 (length) (depth to top)
4 PLAS
 (size) (material)
- (6) pump 1/2 10
 (HP) (yield gpm)
E
 (type power)
- (7) electric log NO
 (yes or no)

(organization running log)

- (8) how well bottom plugged Washed

DRILLERS REMARKS:


DEPT. OF NATURAL RESOURCES
 BUREAU OF LAND & WATER RESOURCES

MAY 23 1983

RECEIVED

If well telescopes please sketch and show depths.

GROUND LEVEL

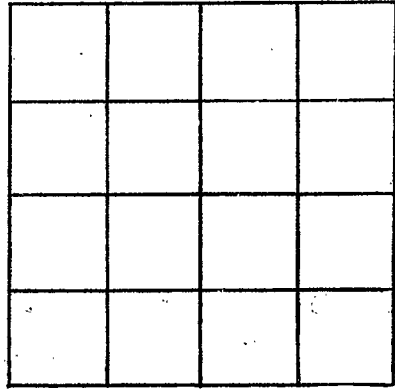

SECTION _____

Please indicate well location X.

ADDITIONAL INFORMATION

If more than one screen, show locations of each on sketch.