

WATER WELL DRILLERS LOG

**CODED**

Date: 9-19, 1963, Driller: James R. Joyce County  
 (Name)

9-19-63

(1) Owner of Land: Bruce Myrick  
 (Name)  
Water Valley  
 (Address)

(2) Location: 1/4, 1/4, Sec. 34 T<sup>10</sup>S R<sup>3</sup>E  
3 miles east of Water Valley  
 (distance) (direction) (Nearest Town)

(3) Topography: Hilly  
 (Hilly) (Flat) (Level)

(4) Purpose of Well: Dom.  
 (Domestic Irrigation  
 Municipal, Industrial, Other)

Description & Color of Materials Sand, Clay, Red Clay, Shell, etc.	Thick- ness Feet	Depth Feet
<u>Clay</u>	<u>0</u>	<u>20</u>
<u>Clay &amp; sand</u>	<u>30</u>	<u>40</u>
<u>w/ sand</u>	<u>40</u>	<u>60</u>

Lafayette Co

~~NOTE:~~

~~Location of this well cannot be obtained~~

~~DEC 3 20 70~~

**CODED**

Information upon completion of well:

(1) Diameter 2 inches.

(2) Total Depth 60 feet.

(3) Water Level 40 feet below top of ground.

(4) Cased to 52, Size 2"


(5) Screen: Size 1 1/4, Length 6'

(6) Were any formations sealed against pollution?  
yes,  no.

If YES depth of formation \_\_\_\_\_

Why \_\_\_\_\_

Drillers Remarks: \_\_\_\_\_

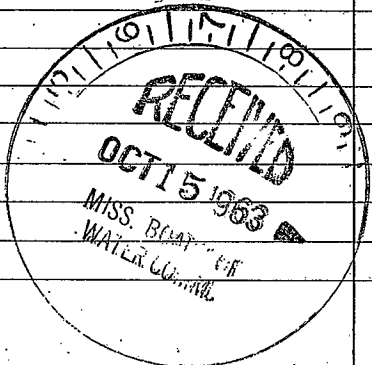

(Use Back Side)

Well No.

Retain this copy for your office files.

