

PANOLA MISSISSIPPI BOARD OF WATER COMMISSIONERS

WATER WELL DRILLERS LOG

Date: 4-1-65, 1965, Driller: J B Cain County Panola

(Name)

(1) Owner of Land:	Description & Color of Materials Sand, Clay, Red Clay, Shell, etc.	Thick- ness Feet	Depth Feet
<u>Stuckeys</u> (Name)	<u>Bro of</u>	<u>0</u>	<u>60</u>
<u>Camo Miss</u> (Address)	<u>Gravel</u>	<u>60</u>	<u>85</u>
(2) Location: <u>1/4</u> , <u>1/4</u> , Sec. <u> </u> T <u> </u> R <u> </u>	<u>Sand</u>	<u>85</u>	<u>145</u>
<u>1</u> miles <u>E</u> of <u>Camo</u> (distance) (direction) (Nearest Town)			
(3) Topography: <input checked="" type="checkbox"/> (Hilly) <input type="checkbox"/> (Flat) <input type="checkbox"/> (Level)			
(4) Purpose of Well: <u>Candy Co</u> (Domestic Irrigation Municipal, Industrial, Other)			

Information upon completion of well:

(1) Diameter 4 inches.

(2) Total Depth 145 feet.

(3) Water Level 100 feet below top of ground.

(4) Cased to 145, Size 4"


(5) Screen: Size 2, Length 5 FT
Locked in Unica Lock

(6) Were any formations sealed against pollution?
_____ yes, _____ no.

If YES depth of formation _____

Why _____

Drillers Remarks: _____

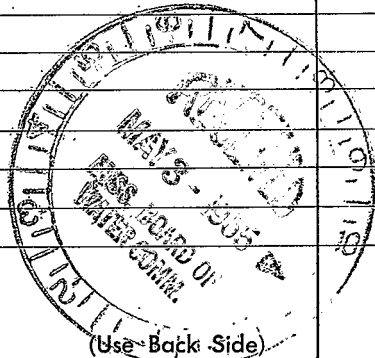

Well No. _____

