

WATER WELL DRILLERS LOG
THORPE WELL SUPPLY CO.

2

8-9-63

Date: 9 Aug, 1963, Driller: [Signature] County: Panola

(Name)

(1) Owner of Land: O.M. Murga
(Name)
Como, Miss.
(Address)

Description & Color of Materials
Sand, Clay, Red Clay, Shell, etc.

Thick-
ness
Feet

Depth
Feet

Top Soil Clay	10	10
Sand	110	120
Clay	90	140
Hard Water Bearing	64	204

(2) Location: 1/4, 1/4, Sec. T R
miles of
(distance) (direction) (Nearest Town)


(3) Topography: Hilly to rolling
(Hilly) (Flat) (Level)

(4) Purpose of Well: Domestic
(Domestic Irrigation
Municipal, Industrial, Other)

Information upon completion of well:

- (1) Diameter 2" inches.
- (2) Total Depth 204 feet.
- (3) Water Level 140' feet below top of ground.
- (4) Cased to 204, Size 2"
- (5) Screen: Size 3" Phant Wall, Length 4'
- (6) Were any formations sealed against pollution?
 yes, no.

If YES depth of formation: Small depth
backfilled To keep
Why: out surface water
Drillers Remarks:

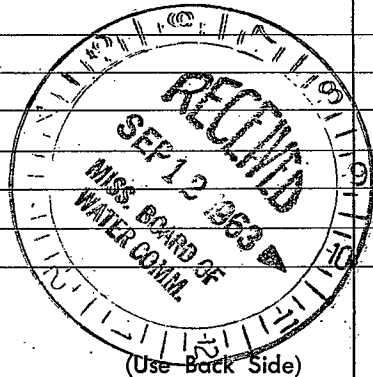

Well No.

[The page contains extremely faint and illegible text, likely bleed-through from the reverse side of the document. No specific content can be transcribed.]