

PANOLA

C6  
9-5-63

WATER WELL DRILLERS LOG

**CODED**

Date: 9-5-1963, Driller: Layne-Central Co. County Panola

(Name)

(1) Owner of Land: Town of Como

(Name)

Como, Mississippi

(Address)

(2) Location: SW 1/4, SE 1/4, Sec. 33 T6S R7W

miles

of

(distance)

(direction)

(Nearest Town)

(3) Topography: 34-30-41-89-56-24

(Hilly)

(Flat)

(Level)

(4) Purpose of Well: Municipal

(Domestic Irrigation  
Municipal, Industrial, Other)

Description & Color of Materials Sand, Clay, Red Clay, Shell, etc.	Thick- ness Feet	Depth Feet
clay	14	0
clay & sand	3	17
red sand	53	70
coarse sand	25	95
coarse sand & gravel	15	110
clay -white	2	112
coarse sand & gravel	6	118
sand	22	140
white clay	13	153
sand	42	195
sand stks clay	9	204

Information upon completion of well:

(1) Diameter 12 inches.

(2) Total Depth 204 feet.

(3) Water Level 87' feet below top of ground.

(4) Cased to 154', Size 12"

(5) Screen: Size 8", Length 40'

(6) Were any formations sealed against pollution?


x yes, no.

If YES depth of formation 154'

Why required

Drillers Remarks:

**CODED**

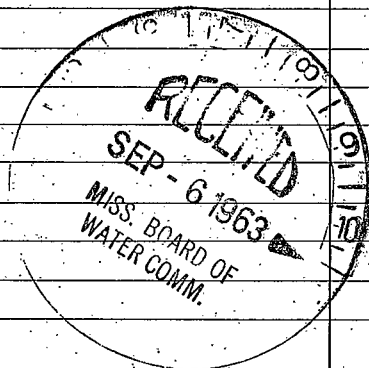

(Use Back Side)

Well No.

e

