

Panola
 C 10,
 3-69

MISSISSIPPI
 BOARD OF WATER COMMISSIONERS
 416 North State Street
 Jackson, Mississippi 39201

CODED

WATER WELL DRILLERS LOG

MARCH 19 69 WHITE Bros. Panola
 date well completed firm name county well located

LANDOWNER: WILLEY FINLEY
POMO, MISS.
RT. 2
 (mailing address)

description of fomations encountered	from	to
TOP SOIL	0	25
MIXED SAND & CLAY	25	60
GRAVEL	60	125
WHITE CLAY	125	131
MED. WHITE SAND	131	146

WELL LOCATION:
 sec. 30 T 6 N R 7 E
 (distance) miles 3 NW of POMO
 (direction) (nearest town)

WELL PURPOSE: HOME
 (home, irrigation, municipal, industrial)

WELL COMPLETION DATA:

(1) diameter (inches) 2"

(2) total depth (feet) 146'

(3) static water level (feet) 95 ^(below) above top of ground.

(4) casing STEEL 140'
 (material) (depth)
2" if telescope see back.
 (size)

(5) screen 4' 146'
 (length) (depth to top)
1 1/4" STAINLESS STEEL
 (size) (material)

(6) pump 3/4 3
 (HP) (yield gpm)
ELE.
 (type power)

(7) electric log NO
 (yes or no)
 (organization running log)

(8) how well bottom plugged STRAINER

CODED


APR 14 1969

MISS. DEPT. OF
 WATER RESOUR.

DRILLERS REMARKS:

If well telescopes please sketch and show depths.

GROUND LEVEL

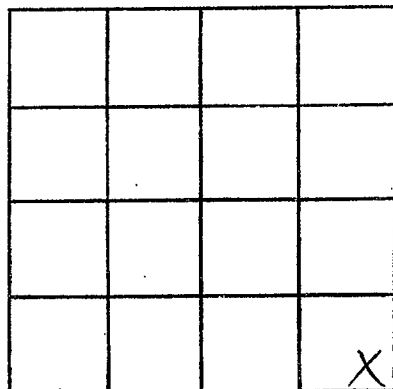

SECTION 30

Please indicate well location X.

ADDITIONAL INFORMATION

If more than one screen, show locations of each on sketch.