

Panola  
 C 11,  
 3-9-69

MISSISSIPPI  
 BOARD OF WATER COMMISSIONERS  
 416 North State Street  
 Jackson, Mississippi 39201

CODED

WATER WELL DRILLERS LOG

MARCH 9 - 1969 WHITE BROS. PANOLA  
 date well completed firm name county well located

LANDOWNER: N.R. SLEDGE  
 Como, Miss.  
 Rt. 1  
 (mailing address)

description of formations encountered	from	to
Top soil	0	30
SAND & LIGHT GRAVEL	30	90
MIXED CLAY & SAND	90	105
COARSE WHITE SAND	105	122

WELL LOCATION:  
 sec. 35 T 6 N R 7 E  
 4 miles EAST of Como  
 (distance) (direction) (nearest town)

WELL PURPOSE: HOME  
 (home, irrigation, municipal, industrial)


WELL COMPLETION DATA:  
 (1) diameter (inches) 2"  
 (2) total depth (feet) 122 FT.  
 (3) static water level (feet) 82 below top of ground.  
 (4) casing STEEL, 116, (material) (depth)  
 2" (size) If telescope see back.  
 (5) screen 4' (length), 122' (depth to top)  
 1 1/4" (size), STAINLESS STEEL (material)  
 (6) pump 3/4 (HP), 3 (yield gpm)  
 ELE. (type power)  
 (7) electric log NO (yes or no)  
 (organization running log)  
 (8) how well bottom plugged STRAINER

DRILLERS REMARKS:

APR 12 1969  
 MISSISSIPPI BOARD OF WATER COMMISSIONERS

If well telescopes please sketch and show depths.

GROUND LEVEL

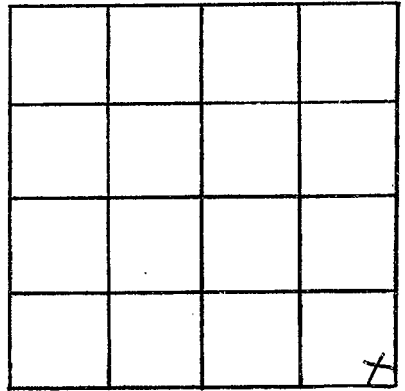

SECTION 35

Please indicate well location X.

ADDITIONAL INFORMATION

If more than one screen, show locations of each on sketch.