

Panola Co
 C 12
 2-15-70

MISSISSIPPI
 BOARD OF WATER COMMISSIONERS
 416 North State Street
 Jackson, Mississippi 39201

CODED

WATER WELL DRILLERS LOG

2-15 1970 Harris Bros Panola
 date well completed firm name county well located

LANDOWNER: <u>Fred Williams</u>	description of formations encountered	from	to
RT. 1 Camo (mailing address)			
WELL LOCATION: sec. 21 T 6 N R 7 E 3 miles N of Camo (distance) (direction) (nearest town)	top soil	0	15
WELL PURPOSE: <u>home</u> (home, irrigation, municipal, industrial)	pl. gravel & sand	15	60
WELL COMPLETION DATA: (1) diameter (inches) <u>4"</u> (2) total depth (feet) <u>130</u> (3) static water level (feet) <u>60</u> ^{below} above top of ground. (4) casing <u>Plastic</u> , <u>123</u> . <u>4"</u> (size) if telescope see back. (material) (depth) (5) screen <u>7'</u> , <u>123</u> . <u>008</u> (size), <u>Plastic</u> (material) (length) (depth to top) (6) pump <u>3/4</u> , <u>10</u> . <u>etc.</u> (HP) (yield gpm) (type power) (7) electric log <u>No</u> (yes or no) (organization running log) (8) how well bottom plugged <u>back</u> <u>not</u>	white clay	60	75
	clay & sand	75	120
	comp. sand	120	130
DRILLERS REMARKS:			


CODED

MAR 25 1970

MISS. BD. OF
 WATER COMMISSIONERS

If well telescopes please sketch and show depths.

GROUND LEVEL

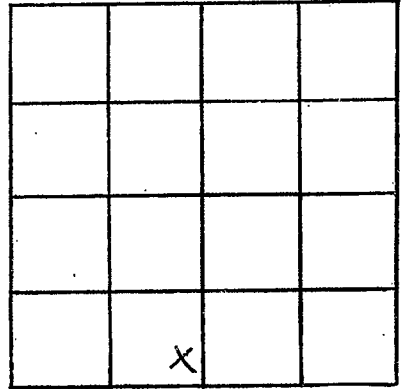

SECTION 21

Please indicate well location X.

ADDITIONAL INFORMATION

If more than one screen,
show locations of each on sketch.